



N. ELEVATION = 396.0'
 ELEVATION = 395.8'±
 P. ELEVATION = 418.7'±

© 2010

L A Y L A K E



20170330000107130 1/1 \$15.00
 Shelby Cnty Judge of Probate, AL
 03/30/2017 02:49:35 PM FILED/CERT

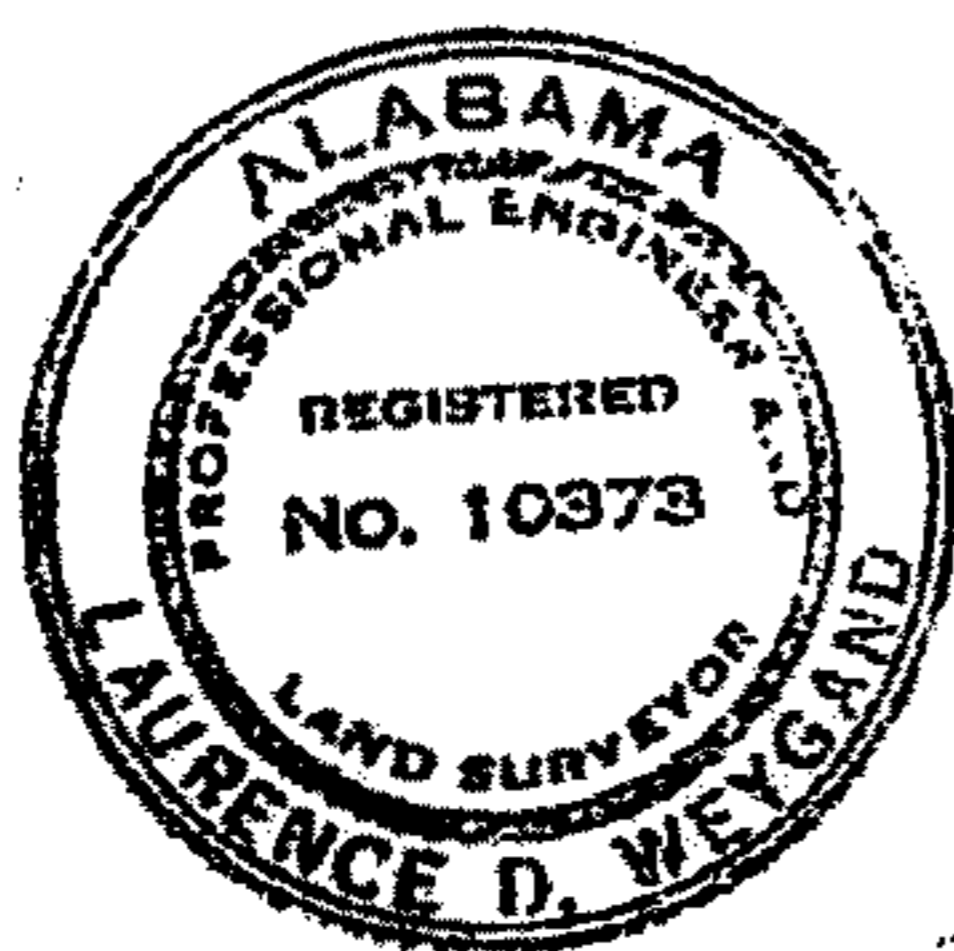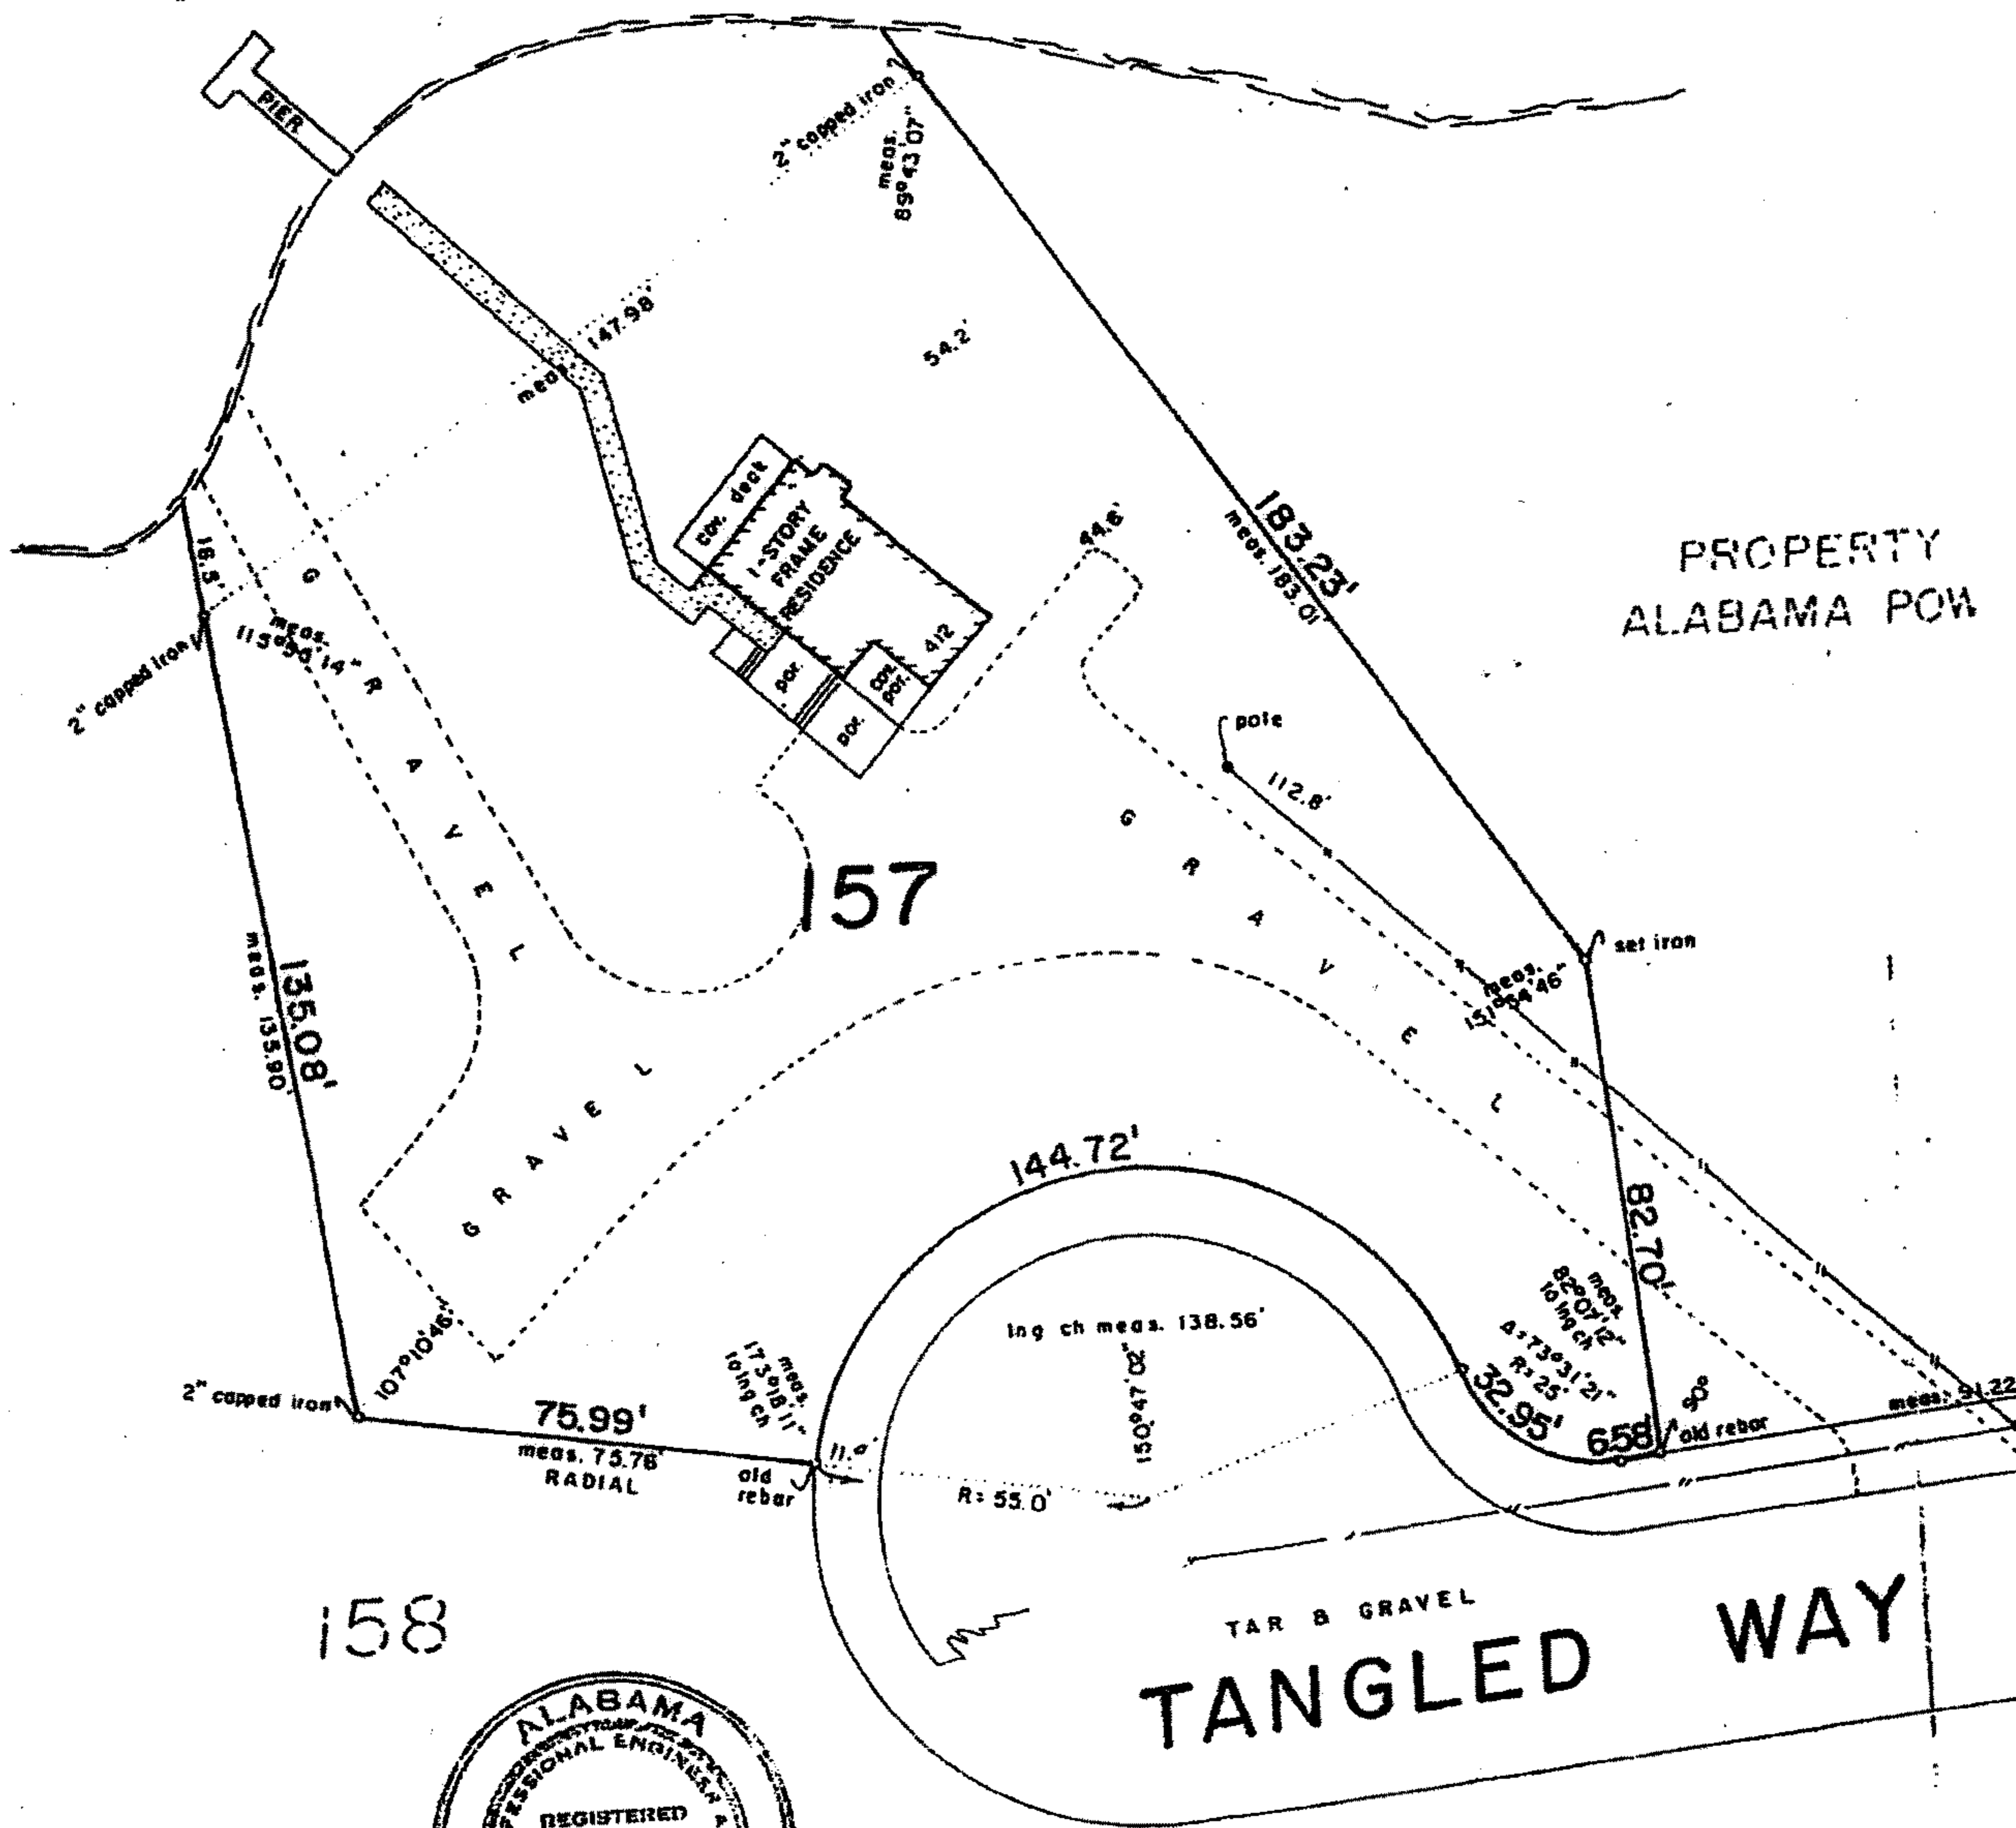

"As-Built Survey"

State of Alabama)
 Shelby County)

I, Laurence D. Weygand, a registered Engineer-Land Surveyor, certify that I have surveyed Lot 157, Alabama Power Company Recreational Cottage Site Sector 7, as recorded in Map Volume 23, Page 28, in the Office of the Judge of Probate, Jefferson County, Alabama, that this survey meets the minimum technical standards for surveys as required by the State of Alabama (using 14" long #5 rebars); and that the correct address is as follows: 412 Tangled Way

According to my survey of: JAN. 13, 1999
 Order No.: 48383
 Purchaser: CARLETTE

Laurence D. Weygand
 Laurence D. Weygand, Reg. P.E. #10373
 169 Oxmoor Road PH: 942-0086
 Homewood, AL 35209

Dayce Ray Stroup

