

19740523000025090 1/3 \$.00
Shelby Cnty Judge of Probate, AL
05/23/1974 12:00:00AM FILED/CERT

*434-0314

5737

See attached drawing

Name and Post Office Address of Grantor Mr. W. E. Driver
P. O. Box 157
Peelham, Alabama 35124
Toll Line (Name)
or Exchange Line Alabaster
Tributary to (Exchange)
The Property is bounded where the line enters and leaves this property by the property of:
U. S. Hwy 31 on the West
and _____ on the _____
The following identification:
Authority * Classification 945C
Area Birmingham South
Approved _____
Title District Engineer-South
NORTH

FORM 8419 SC
NOV. 1968

PERMIT - BURIED LINES

In consideration of the benefits to be received and of other good and valuable consideration received from South Central Bell Telephone Company, (I) (We) hereby grant said Company, its associated and allied companies, their respective licensees, successors and assigns, the right to construct, operate and maintain, add or remove lines or systems of communications consisting of such buried cables and wires, cable terminals, markers, splicing boxes and pedestals, conduits, manholes, underground cables and wires and any other amplifiers, boxes, appurtenances or devices as grantee may require upon, across, over and/or under that certain tract of land situated in Shelby County, State of Alabama, to-wit: That tract of land located in County Section 13, Range 3 West, Township 20 South.

and, to the fullest extent the undersigned has the power to grant, if at all, upon, along, and under the roads, streets or highways adjoining or through said property, with the right to permit the attachment of, and/or carry in conduit or trenches, wires and cables of any other person or company for communication purposes or for the transmission and distribution of electric power, and the right of ingress and egress to said premises at all times for the purpose of inspecting and maintaining said line, and with the right to clear and keep cleared all trees, undergrowth or other obstructions within a strip of land 5 feet on each side of the center of said line, and to trim and cut and keep trimmed and cut all dead, weak, leaning or dangerous trees which might reach said line in falling, including the right to relocate said line on said premises to conform to any future highway relocation, widening or improvement.

Signed, sealed and delivered
in the presence of:

5-10, 1974

M. S. Abbott
Witness

Seal

Seal

Attest:

Name of Corporation

Corporate Officer

X By:

Title:

W. E. Driver

BOOK 287 PAGE 55

TO
ALABASTER

U.S HWY. # 31

TO CO. ← SOD 654
1200' (R)
(2576')
BKMS-2
01,201-300
01,101-200
14.8 K.F.
BKMA-50
01,51-100
1376' (R)
22' UP POLE
P. 18-B
P. 21-E
P. 18-B
Hwy 31

DAIRY
QUEEN

0	4/74
6	4/75
26	ULT. LINES

MC I # 109
165' (CL)
148' (F)
AJMA-50
01,201-250

U.C.

U.C.

BOOK 287 PAGE 56

CAUTION!
CHECK FOR
BAD POLLS

NOTES TO CONSTRUCTION.


LOCATE ALL UTILITIES
BEFORE DIGGING.
VERBAL PERMISSION TO
BURY ON PRIVATE
PROP. GIVEN BY
MR. W.E. DRIVER (4-16-74)
WRITTEN PERMIT TO
BE FOLLOWING.

CONCRETE
CA MKR (4")
CAUTION!
WATER & SEPTIC
TANK PIPES

54'




19740523000025090 2/3 \$.00
Shelby Cnty Judge of Probate, AL
05/23/1974 12:00:00AM FILED/CERT

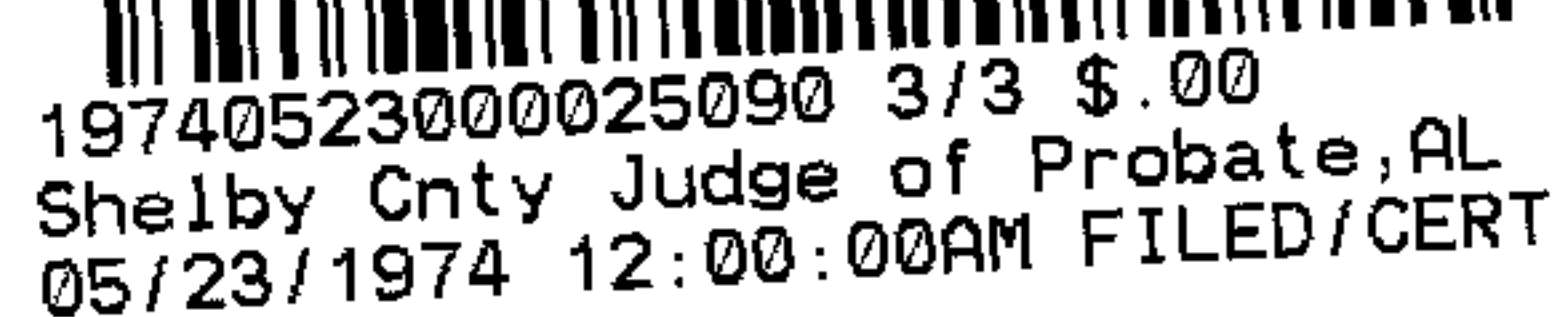

8409-KT SC
APRIL 1968

TH BOUND LANE

To B' HAM

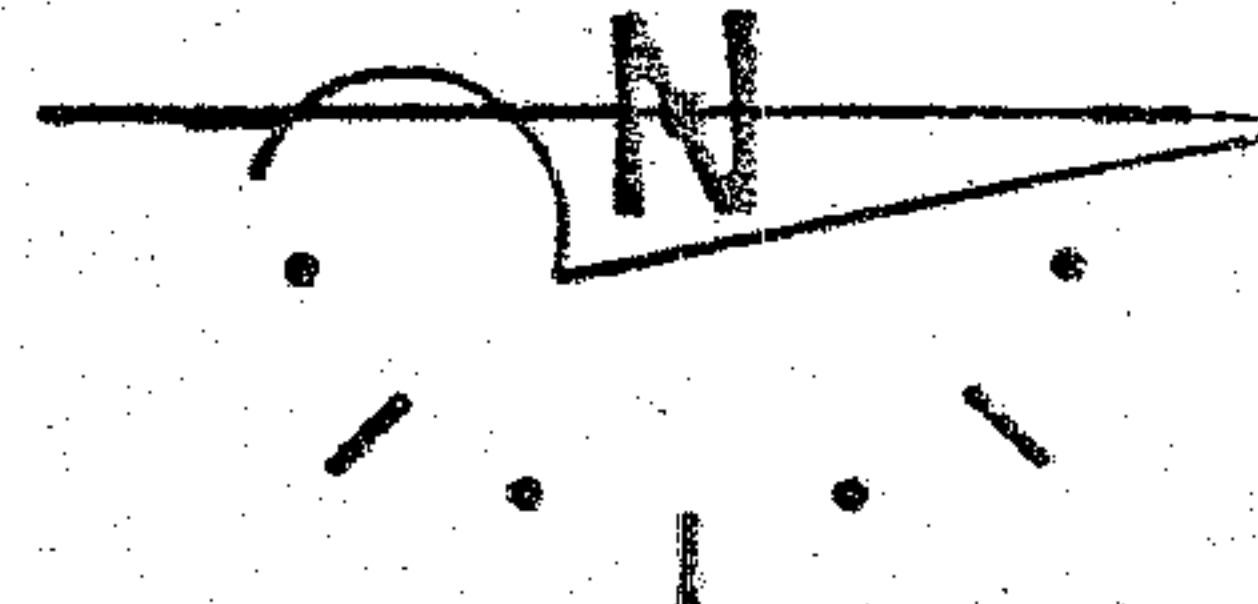

-BKMS-2-
01, 201-300
01, 101-200

CAUTION! HIGH
VOLTAGE 7.2 KV

BOOK 287 PAGE 57

RUSH

SERVICE TO BE
REQUIRED IN
30 DAYS.

FRANKS RESTAURANT

STATE OF ALA. SHELBY CO.
I CERTIFY THIS
INSTRUMENT WAS FILED
Filed July 56
1974 MAY 23 AM 8:06
U.C.C. FILE NUMBER OR
REC. BK. & PAGE AS SHOWN ABOVE
Correctly in 2nd volume
JUDGE OF PROBATE

MACH. TR. CA. 24"
JOB STAKED

PED. # 18-8-1 W
1-134A1A-50
2: 66M1-50 C.B.
1-MC10/48

FDSR (HUC) 30 DAYS

DATE	4-18-1974
GR. EXP.	535
PLT. RET.	-
SALVAGE	-
MTCE.	-
GR. ADDNS.	535
N. Y. CAT.	G/10
APPROVED:	
DISTRICT ENGINEER	
DATE	18

TAX DIST. 05818		△							
RECORDS REF. 0210-A5 0210-A4		△							
		△							
		ISSUE		DATE		ENG.		APVD.	
								NATURE OF REVISION	
								SOUTH CENTRAL BELL TELEPHONE COMPANY	
ZONE —		ALABASTER - ALABAMA				ENG. MSA		DFTM. BM	
CODE 1A.4		DISTRIBUTION FACILITIES TO SERVE OFFICE BUILDING UNDER CONSTRUCTION.				APVD. R		DATE 4	
HV JU V TO G						D		19	
7.2KV		NO SCALE				MY		74	
								1 OF 1	