

4/10 Consideration

540006

Job No. 61700-00-0034-0-00
STA 1100 To STA 1+235

Application For Electric Service Made By Applicant
Owning The Land And Premises To Be Served; And
Grant Of Land Easement By Landowner For Use Of
Alabama Power Company In Providing Such Electric Service

1. Landowner (s) MRS S. D. Wheeler, a widow (Grantor) hereby
applies to Alabama Power Company (Company) for electrical service at 117 1/2 CEDAR COVE LANE,
PELHAM, AL. 35124

Grantor is the owner of the land and premises located at the above address, which by the parties are deemed to be
legally described herein precisely as described and mapped in Grantor's ad valorem tax assessment for such land and
premises in the office of the Tax Assessor of SHELBY County, Alabama,
as if herein set out in full detail.

2. To provide the requested electric service Company must install on such premises, from time to time, some or all
of the following: electric poles, electric distribution lines, service laterals, metering equipment, transformers, guys, and
equipment related thereto, both above and below ground, and must accomplish the cutting and trimming of trees both
now and in the future to accommodate such facilities.

3. Grantor, in consideration of (a) the construction of the necessary service facilities and (b) the furnishing of
electric service at Company's published rates, hereby grants, (for himself, his heirs, successors and assigns) to
Company the right to install, improve, remove, maintain, and replace, upon, over, and under the above described
lands such of the above electric facilities as are appropriate in the opinion of Company, to provide such requested
service, at locations on Grantor's land deemed appropriate for such service by Company, and agreed to by Grantor, at
time of original extension of service (together with necessary and reasonable changes therein and extensions thereto to
serve the land and premises) and construction of facilities, together with the right to clear and keep cleared all growth
or obstructions within a strip of land fifteen feet on either side of the facilities as constructed, that would in the opinion
of Company interfere with such facilities. The precise physical location on the land where the facilities are installed
shall be conclusively deemed to be the location described in this grant for the placement of all such facilities. It is the
intention of the parties that this grant shall be an easement on, under and over Grantor's land and shall bind in the
future Grantor's successors, heirs and assigns.

4. Alabama Power Company shall have the rights of ingress and egress to and from the within described land and
premises for the purpose of installing, constructing, operating and maintaining its facilities in accordance with
accepted industry standards.

TO HAVE AND TO HOLD such easement to Alabama Power Company, its successors and assigns, forever.

Given under my hand and seal this the 1st day of FEBRUARY, 1990.

WITNESS:

GRANTOR (S)
LANDOWNER OR LANDOWNERS

Mrs S D Wheeler (SEAL)

(SEAL)

(SEAL)

(SEAL)

NW 1/4 - SE 1/4

Sec. 11

T. 20S

R. 3W

This instrument prepared in
the Corporate Real Estate
Dept. of Alabama Power Co.
Birmingham, Ala.

By Walter Hefner

GRANTEE'S ADDRESS
ALABAMA POWER CO.
P. O. BOX 2641
BIRMINGHAM, AL 35291
ATT: CORP. REAL ESTATE

Witness:

_____	_____ (Seal)
_____	_____ (Seal)
IN WITNESS WHEREOF, the said _____ has caused
this instrument to be executed in its name by _____ as
its President and attested by _____, its Secretary, and its
corporate seal to be affixed, on this the _____ day of _____, 19____.

Attest

Secretary.

By _____
Its President.

STATE OF Alabama
County of Shelby }

I, Don D. Bailey, NOTARY PUBLIC STATE AT LARGE
in and for said County in said State, hereby certify that Mrs S. D. Wheeler, a widow


_____ whose name is
signed to the foregoing instrument and who is known to me, acknowledged before me on this day that
being informed of the contents of the instrument she executed the same voluntarily, on the day the same
bears date.

Given under my hand and official seal this the 1st day of February, 1990.

Don D. Bailey
NOTARY PUBLIC STATE AT LARGE

Alabama Power

WE No. 61700-00-00340-00		Customer S.D. WHEELER		Estimate No.	
Division B'HAM		District NORTH SHELBY		Town PELHAM	
Scale N/T3		Section 11		Township 20S	
PL Per Inch		Range 3W		Map Reference 3W-20-11-4	
				Date 1/30/99	

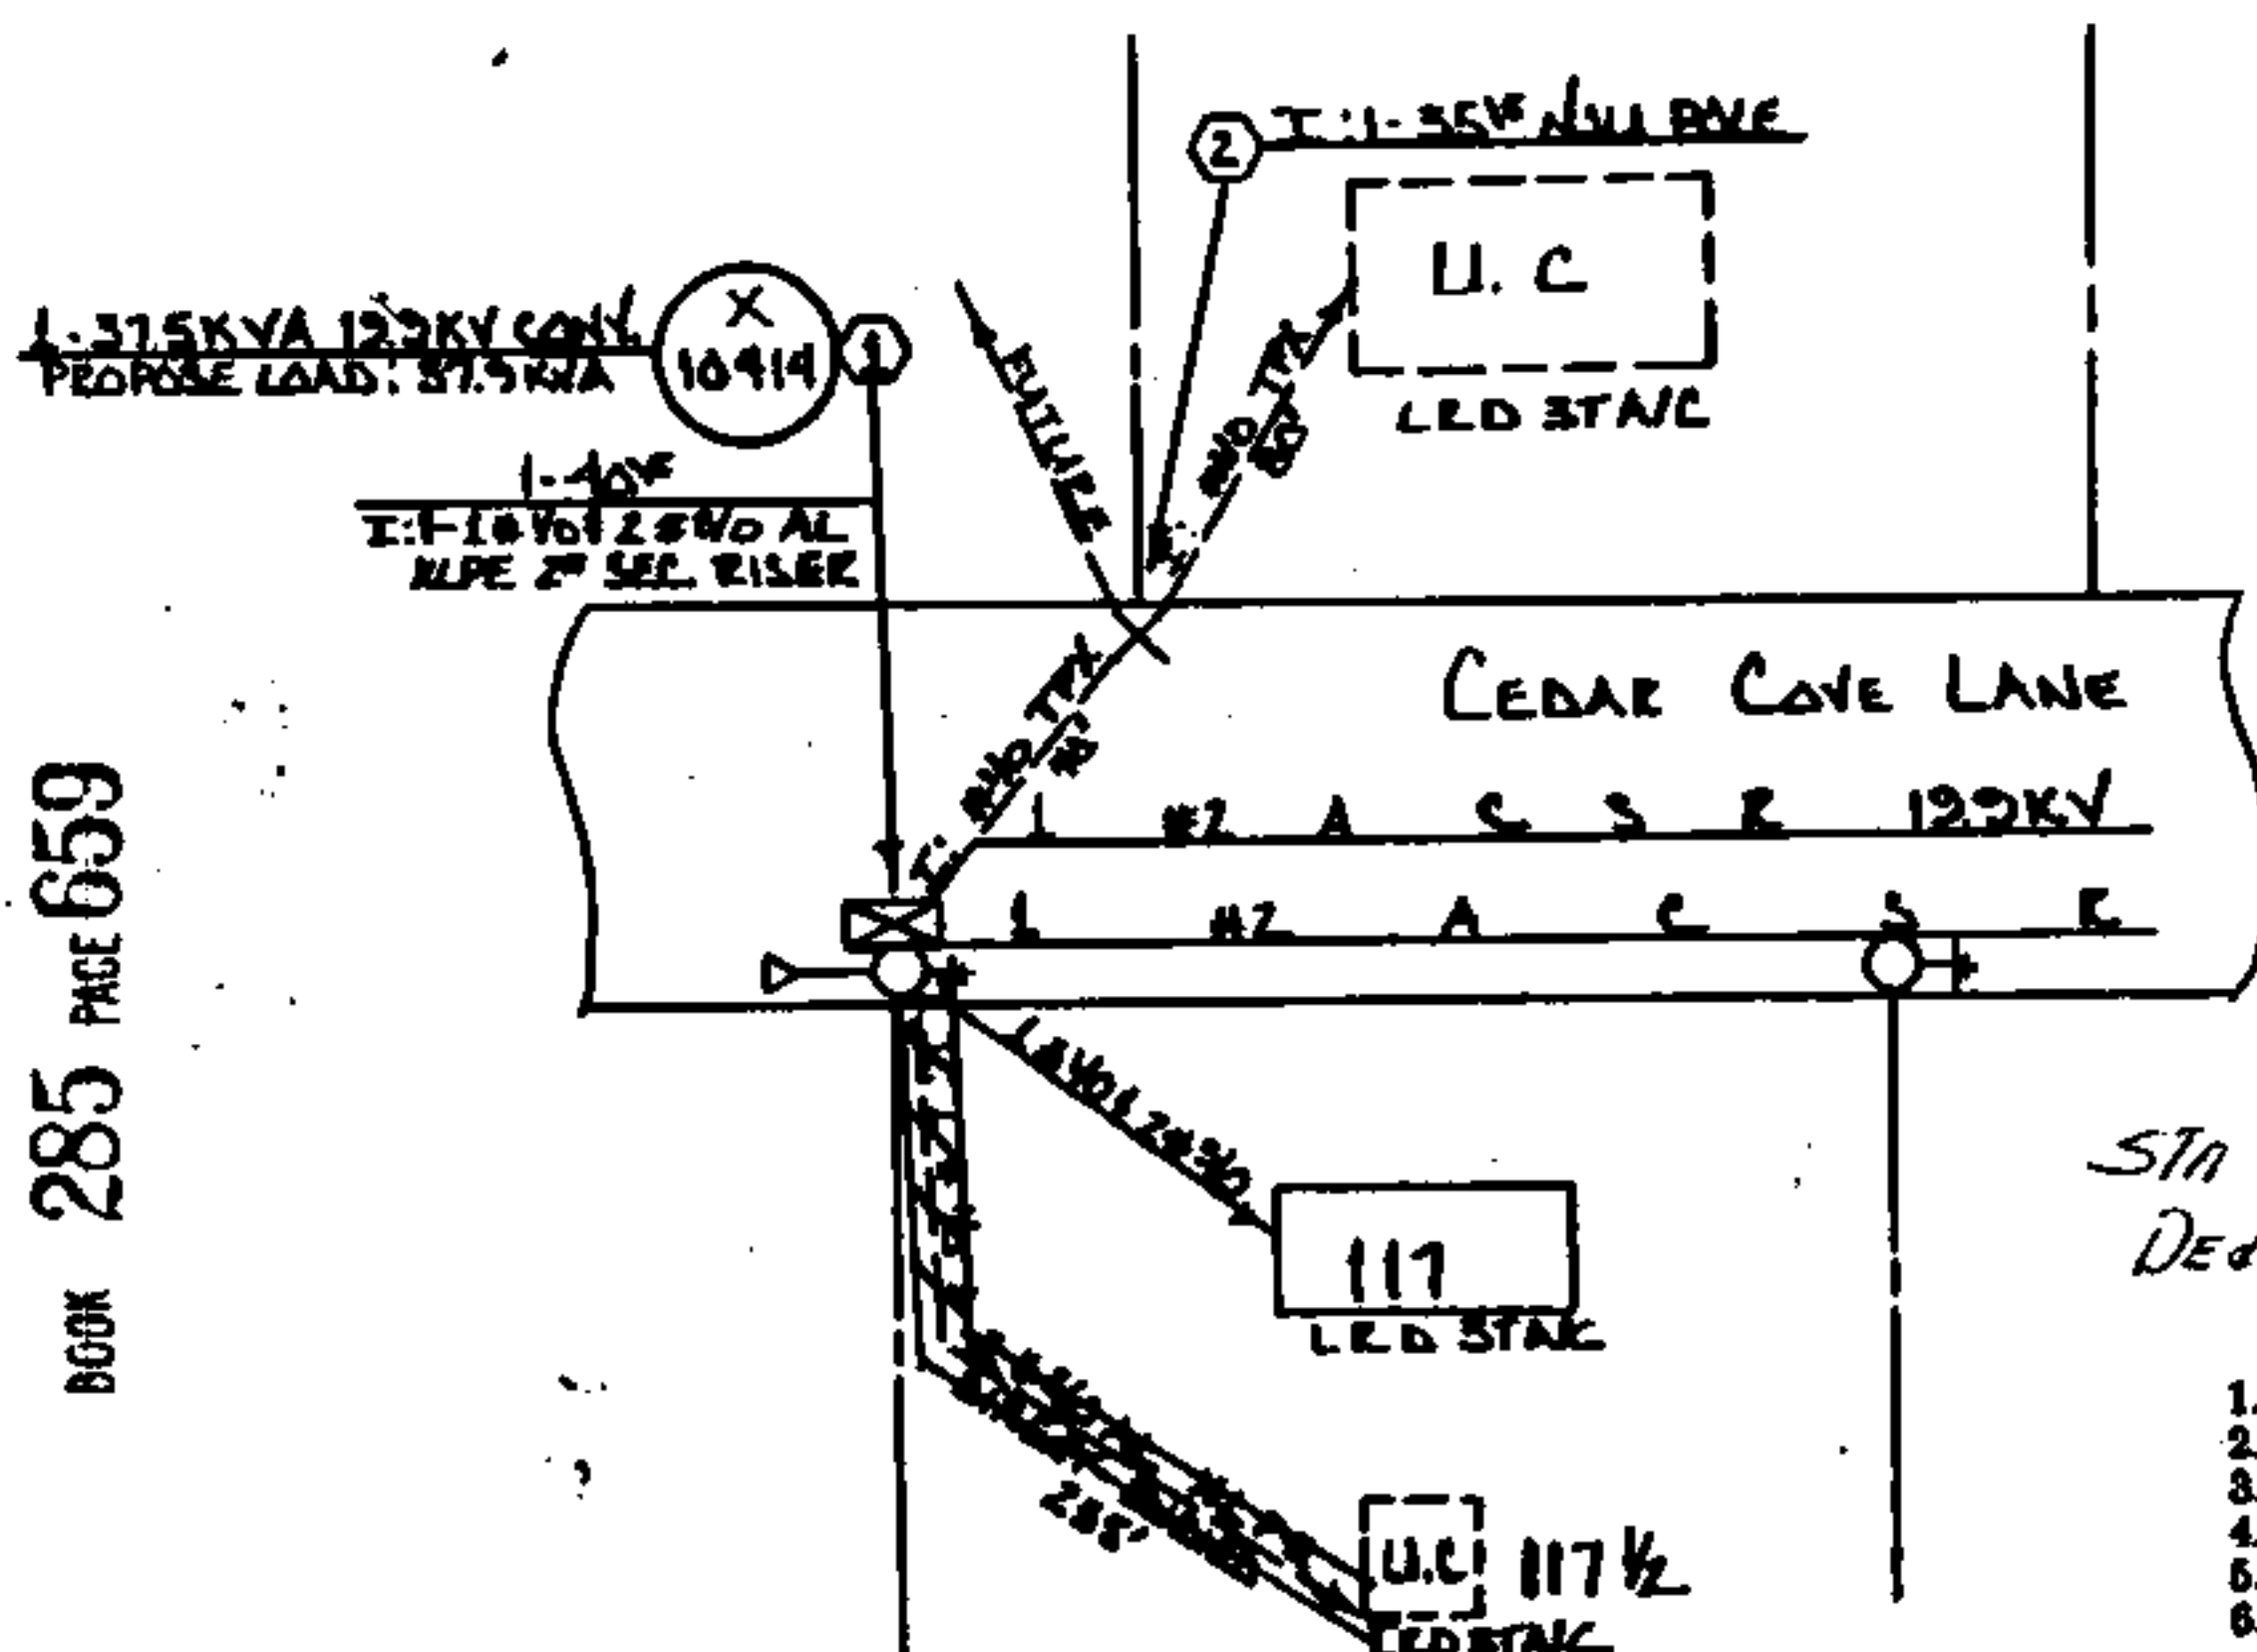

STA 1+00 To STA 2+00
DEDICATED CITY STREET

1. Deed Tax	\$ 1.50
2. Mtg. Tax	\$
3. Recording Fee	\$ 2.50
4. Indexing Fee	\$ 3.00
5. No Tax Fee	\$
6. Certified Fee	\$ 1.00
Total	\$ 12.00

RELATION SKETCH

Bucket 100%
Transf. Cart /
Hand Hole /
Rock /
Tree Crew /
Staked /
Permit RM
Work with S

STATE OF ALA. SHERIFF CO.
I CERTIFY THIS
INSTRUMENT WAS FILED

90 APR -4 AM 10: 39

UNION OF PROTEST

NOTE: THE CUSTOMER IS TO PAY \$475.00
AS AID TO CONSTRUCTION PER MP 715-103
*MR FOREMAN PLEASE NOTIFY JIM PRICE
AT 665-4262 SEVERAL DAYS IN ADVANCE
TO TERMINATE TRENCH OPENING WITH
COMPLETION OF THE JOB.

