

**RESTRICTIVE COVENANTS and  
GRANT OF LAND EASEMENT for  
Underground Facilities in Subdivision**

**DOCUMENT TO BE RECORDED**

Thi

20050801000385550 1/3 \$17.50  
Shelby Cnty Judge of Probate, AL  
08/01/2005 12:07:04PM FILED/CERT

**(NOTE: DO NOT RECORD WITHOUT  
ATTACHED PLAT OR DRAWING!)**

Jeff J. Callicott

STATE OF ALABAMA }  
COUNTY OF Shelby }

W.E. No. 61700-08-001134  
Parcel No. 70150845

Alabama Power Company  
Corporate Real Estate  
P. O. Box 2641  
Birmingham, Alabama 35291

**KNOW ALL MEN BY THESE PRESENTS, THAT: WHEREAS,** the "Grantor", (whether one or more) are owners of record of the following described real estate in Shelby County, Alabama, to wit: Villas Belvedere - Phase II (the "Subdivision") as shown on the plat or drawing attached and incorporated herein by reference, which Grantor plans to record in the Office of the Judge of Probate, Shelby County, Alabama (the "Property") ( SE  $\frac{1}{4}$  of SE  $\frac{1}{4}$  of Section 34, Township 18 South, Range 1 West ) and,

**WHEREAS,** the said Grantor desires to grant to Alabama Power Company, (the "Company") an easement for underground electrical facilities and to establish and place the Subdivision under certain restrictive covenants to insure the use of the property for attractive residential purposes and thereby to secure to each lot owner the same advantages insured to other lot owners.

**NOW, THEREFORE,** The Grantor, for and in consideration of *One and No/100 Dollars (\$1.00)*, and other good and valuable consideration, to Grantor in hand paid by the Company, the receipt of which is hereby acknowledged, does hereby grant to Company, its successors and assigns, the right to construct, install, operate, maintain and replace, along a route to be selected by the Company (generally shown on the attached drawing), its successors or assigns, all conduits, cables, transclosures and other appliances and facilities (above ground and below ground) useful or necessary in connection therewith, for the underground transmission and distribution of electric power and for underground communication service upon, under and across the Property.

Together with all the rights and privileges necessary or convenient for the full enjoyment or use thereof, including the right of ingress and egress to and from said facilities and the right to excavate for installation, replacement, repair and removal thereof; and also the right to cut and keep clear any and all obstructions or obstacles of whatever character on, under and above said facilities.

**TO HAVE AND TO HOLD** such easement to the Company, its successors and assigns, forever.

And, the undersigned Grantors further does hereby adopt the following conditions, restrictions, covenants and limitations which shall apply in their entirety to all lots in the said Subdivision and shall run with the title to said property, and which shall be included in any conveyance of title to any or all of said lots in said subdivision:

1. The owners of lots within the Subdivision will not erect or grant to any person, firm or corporation the right, license or privilege to erect or use or permit the use of overhead wires, poles or overhead facilities of any kind for electrical, telephone, or cable television service on said real estate (except such poles and overhead facilities as may be required at those places where distribution facilities enter and leave said subdivision, or existing and/or future overhead transmission or communication facilities on existing Alabama Power Company rights of way). Nothing herein shall be construed to prohibit overhead street lighting, or ornamental yard lighting, where serviced by underground wires or cables.

2. In order to beautify said Subdivision for the benefit of all lot owners and permit Alabama Power Company to install underground electric service to each house in said Subdivision for the mutual benefit of all lot owners therein, no owner of any lot within said Subdivision will commence construction of any house on any lot until such owner (1) notifies Alabama Power Company that such construction is proposed, (2) grants in writing to Alabama Power Company such rights and easements as Alabama Power Company deems necessary in connection with its construction, operation, maintenance, replacement and removal of underground service laterals of each lot, and (3) otherwise complies with the Rules and Regulations for Underground Residential Distribution on file with and approved by the Alabama Public Service Commission. Further, no plants, shrubs, fences, walls or other obstructions shall be placed in front of or within three (3) feet of any side of any pad-mounted equipment and Alabama Power Company shall not be liable for any damages to or destruction of any shrubs, trees, flowers, grass or other plants caused by the equipment or employees of the Company or its contractors engaged in the construction, operation, maintenance, replacement or removal of the Company's facilities. Appropriate meter locations must be obtained from Alabama Power Company prior to installing or relocating service entrance facilities and associated internal wiring. Owners must install meter sockets provided by Alabama Power Company to the Company's specifications, and shall provide and install conduit from the meter socket as specified by the Company.

3. Alabama Power Company, its successors and assigns, will retain title to all underground facilities installed by the Company or its contractors, including but not limited to the service lateral and outdoor metering socket serving each said house, and said service entrance facilities provided by Alabama Power Company will not in any way be considered a fixture or fixtures and thereby a part of said real estate, but will remain personal property belonging to Alabama Power Company, its successors and assigns, and will be subject to removal by Alabama Power Company, its successors and assigns, in accordance with applicable Rules and Regulations filed with and approved by the Alabama Public Service Commission.

4. These covenants and restrictions touch and concern and benefit the land and shall run with the land and shall be binding on Alabama Power Company, the undersigned, their respective heirs, successors and assigns. Invalidation of any one of the foregoing covenants and restrictions shall in no way affect any other provision contained herein.

Shelby County, AL 08/01/2005  
State of Alabama

5-5897 6/03

Deed Tax: \$.50

THIS PERMIT COVERS ALL COMPANY FACILITIES  
LOCATED ALONG THE ROUTE SHOWN  
ON THE ATTACHED DRAWING WITHIN  
THE SUBDIVISION IDENTIFIED HEREIN.



IN WITNESS WHEREOF, this instrument has been executed this the 25th day of JANUARY, 2005.

WITNESS/ATTEST

GRANTOR:

Charles D. Arcene

D.R. Horton, Inc

Name of Individual/Company/Partnership/LLC

Michael J. Inman  
Signature of Individual/Officer/Partner

=====

**CORPORATE/PARTNERSHIP ACKNOWLEDGMENT**

STATE OF ALABAMA }

County of Jefferson }

I, Brenda L. Gibson, a Notary Public, in and for said County in said State, hereby certify that, Michael Inman whose name as DIVISION PRESIDENT of D.R. Horton Inc - Birmingham, a corporation/partnership, is signed to the foregoing instrument, and who is known to me, acknowledged before me on this day that being informed of the contents of the instrument, he/she, as such officer/partner and with full authority, executed the same voluntarily for and as the act of said corporation/partnership.

Given under my hand and official seal, this the 25th day of JANUARY, 2005.

Brenda L. Gibson  
Notary Public

My commission expires: \_\_\_\_\_

=====


**INDIVIDUAL ACKNOWLEDGMENT**

STATE OF ALABAMA }

County of \_\_\_\_\_ }

I, \_\_\_\_\_, a Notary Public in and for said County, in said State, hereby certify that \_\_\_\_\_, whose name(s) (is/are) signed to the foregoing instrument, and who (is/are) known to me, acknowledged before me on this date that, being informed of the contents of the agreement, (has/have) executed the same voluntarily on the day the same bears date.

Given under my hand and official seal, this the \_\_\_\_\_ day of \_\_\_\_\_, 20\_\_\_\_.

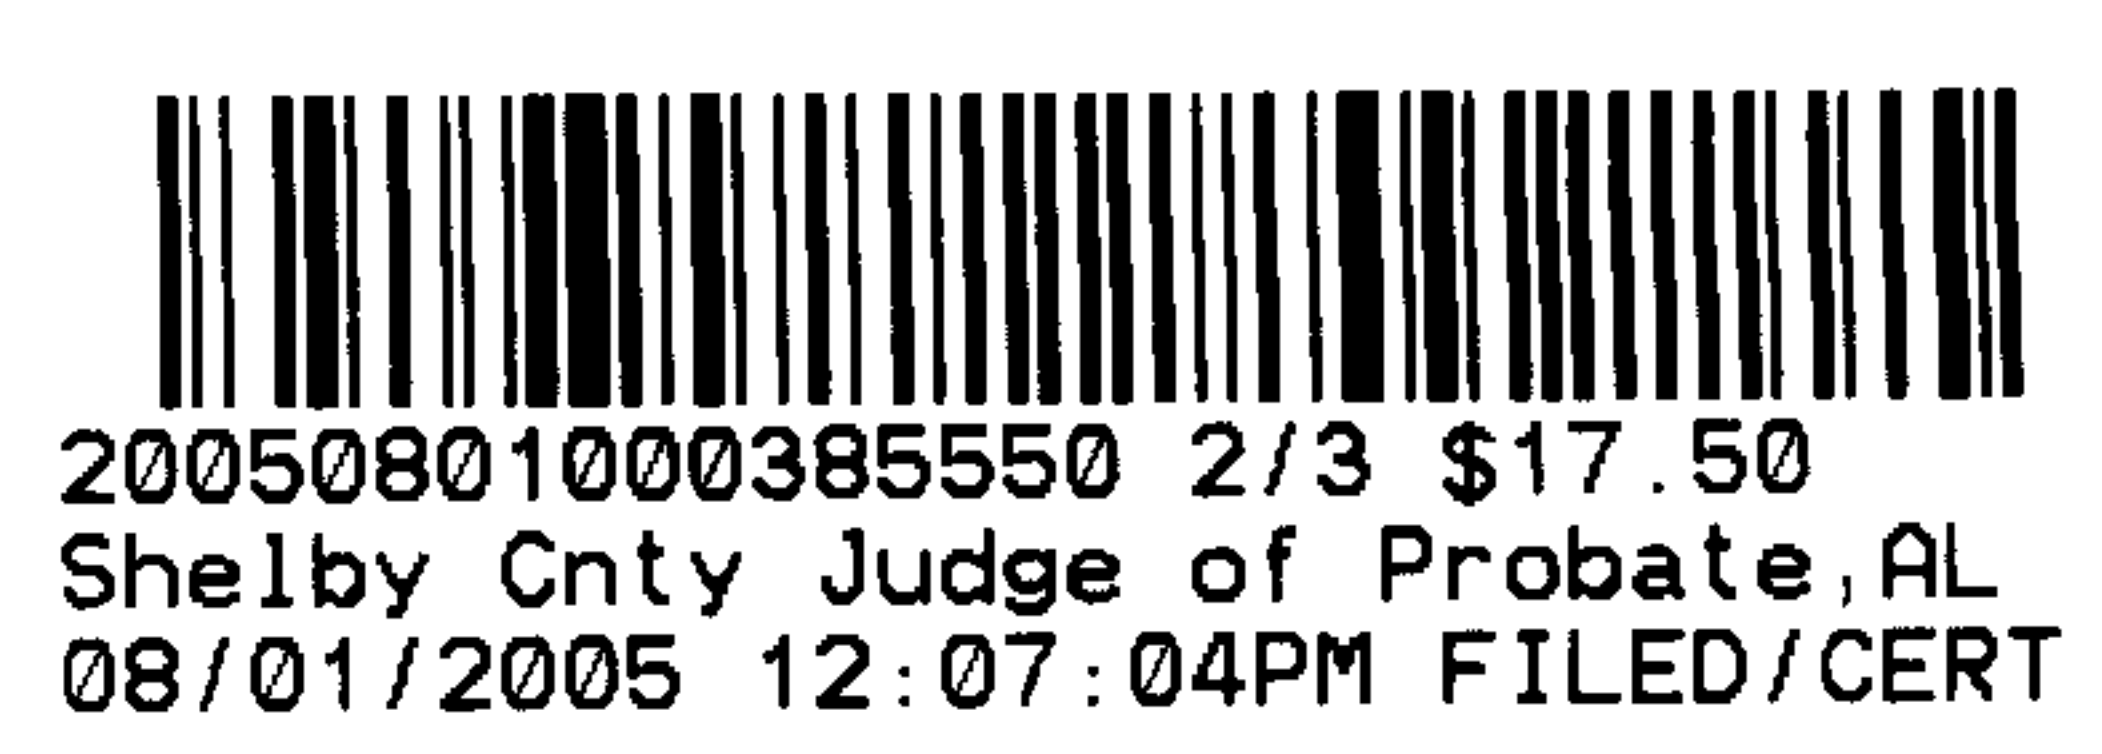

Notary Public

My commission expires: \_\_\_\_\_



1. 45/4 CCA POLE  
34' PRI TANG w/28 3/4" & 1" & 1/2"  
PRI RISER w/4" L-QUARD  
100A CUTOUT  
FUSE 50A

2. 45/4 CCA POLE  
34' PRI TANG w/28 3/4" & 1" & 1/2"  
PRI RISER w/4" L-QUARD  
100A CUTOUT  
FUSE 50A

3. 50KVA 19.5KV DPM XFR  
SWITCHABLE  
FL=56.5KVA


4. 50KVA 19.5KV DPM XFR  
SWITCHABLE  
FL=48.5KVA

5. 75KVA 19.5KV DPM XFR  
SWITCHABLE  
FL=65.5KVA  
BOX PAD

6. 75KVA 19.5KV DPM XFR  
SWITCHABLE  
FL=67.5KVA

7. 75KVA 19.5KV DPM XFR  
SWITCHABLE  
FL=67.5KVA  
BOX PAD

8. SECONDARY PEDISTAL

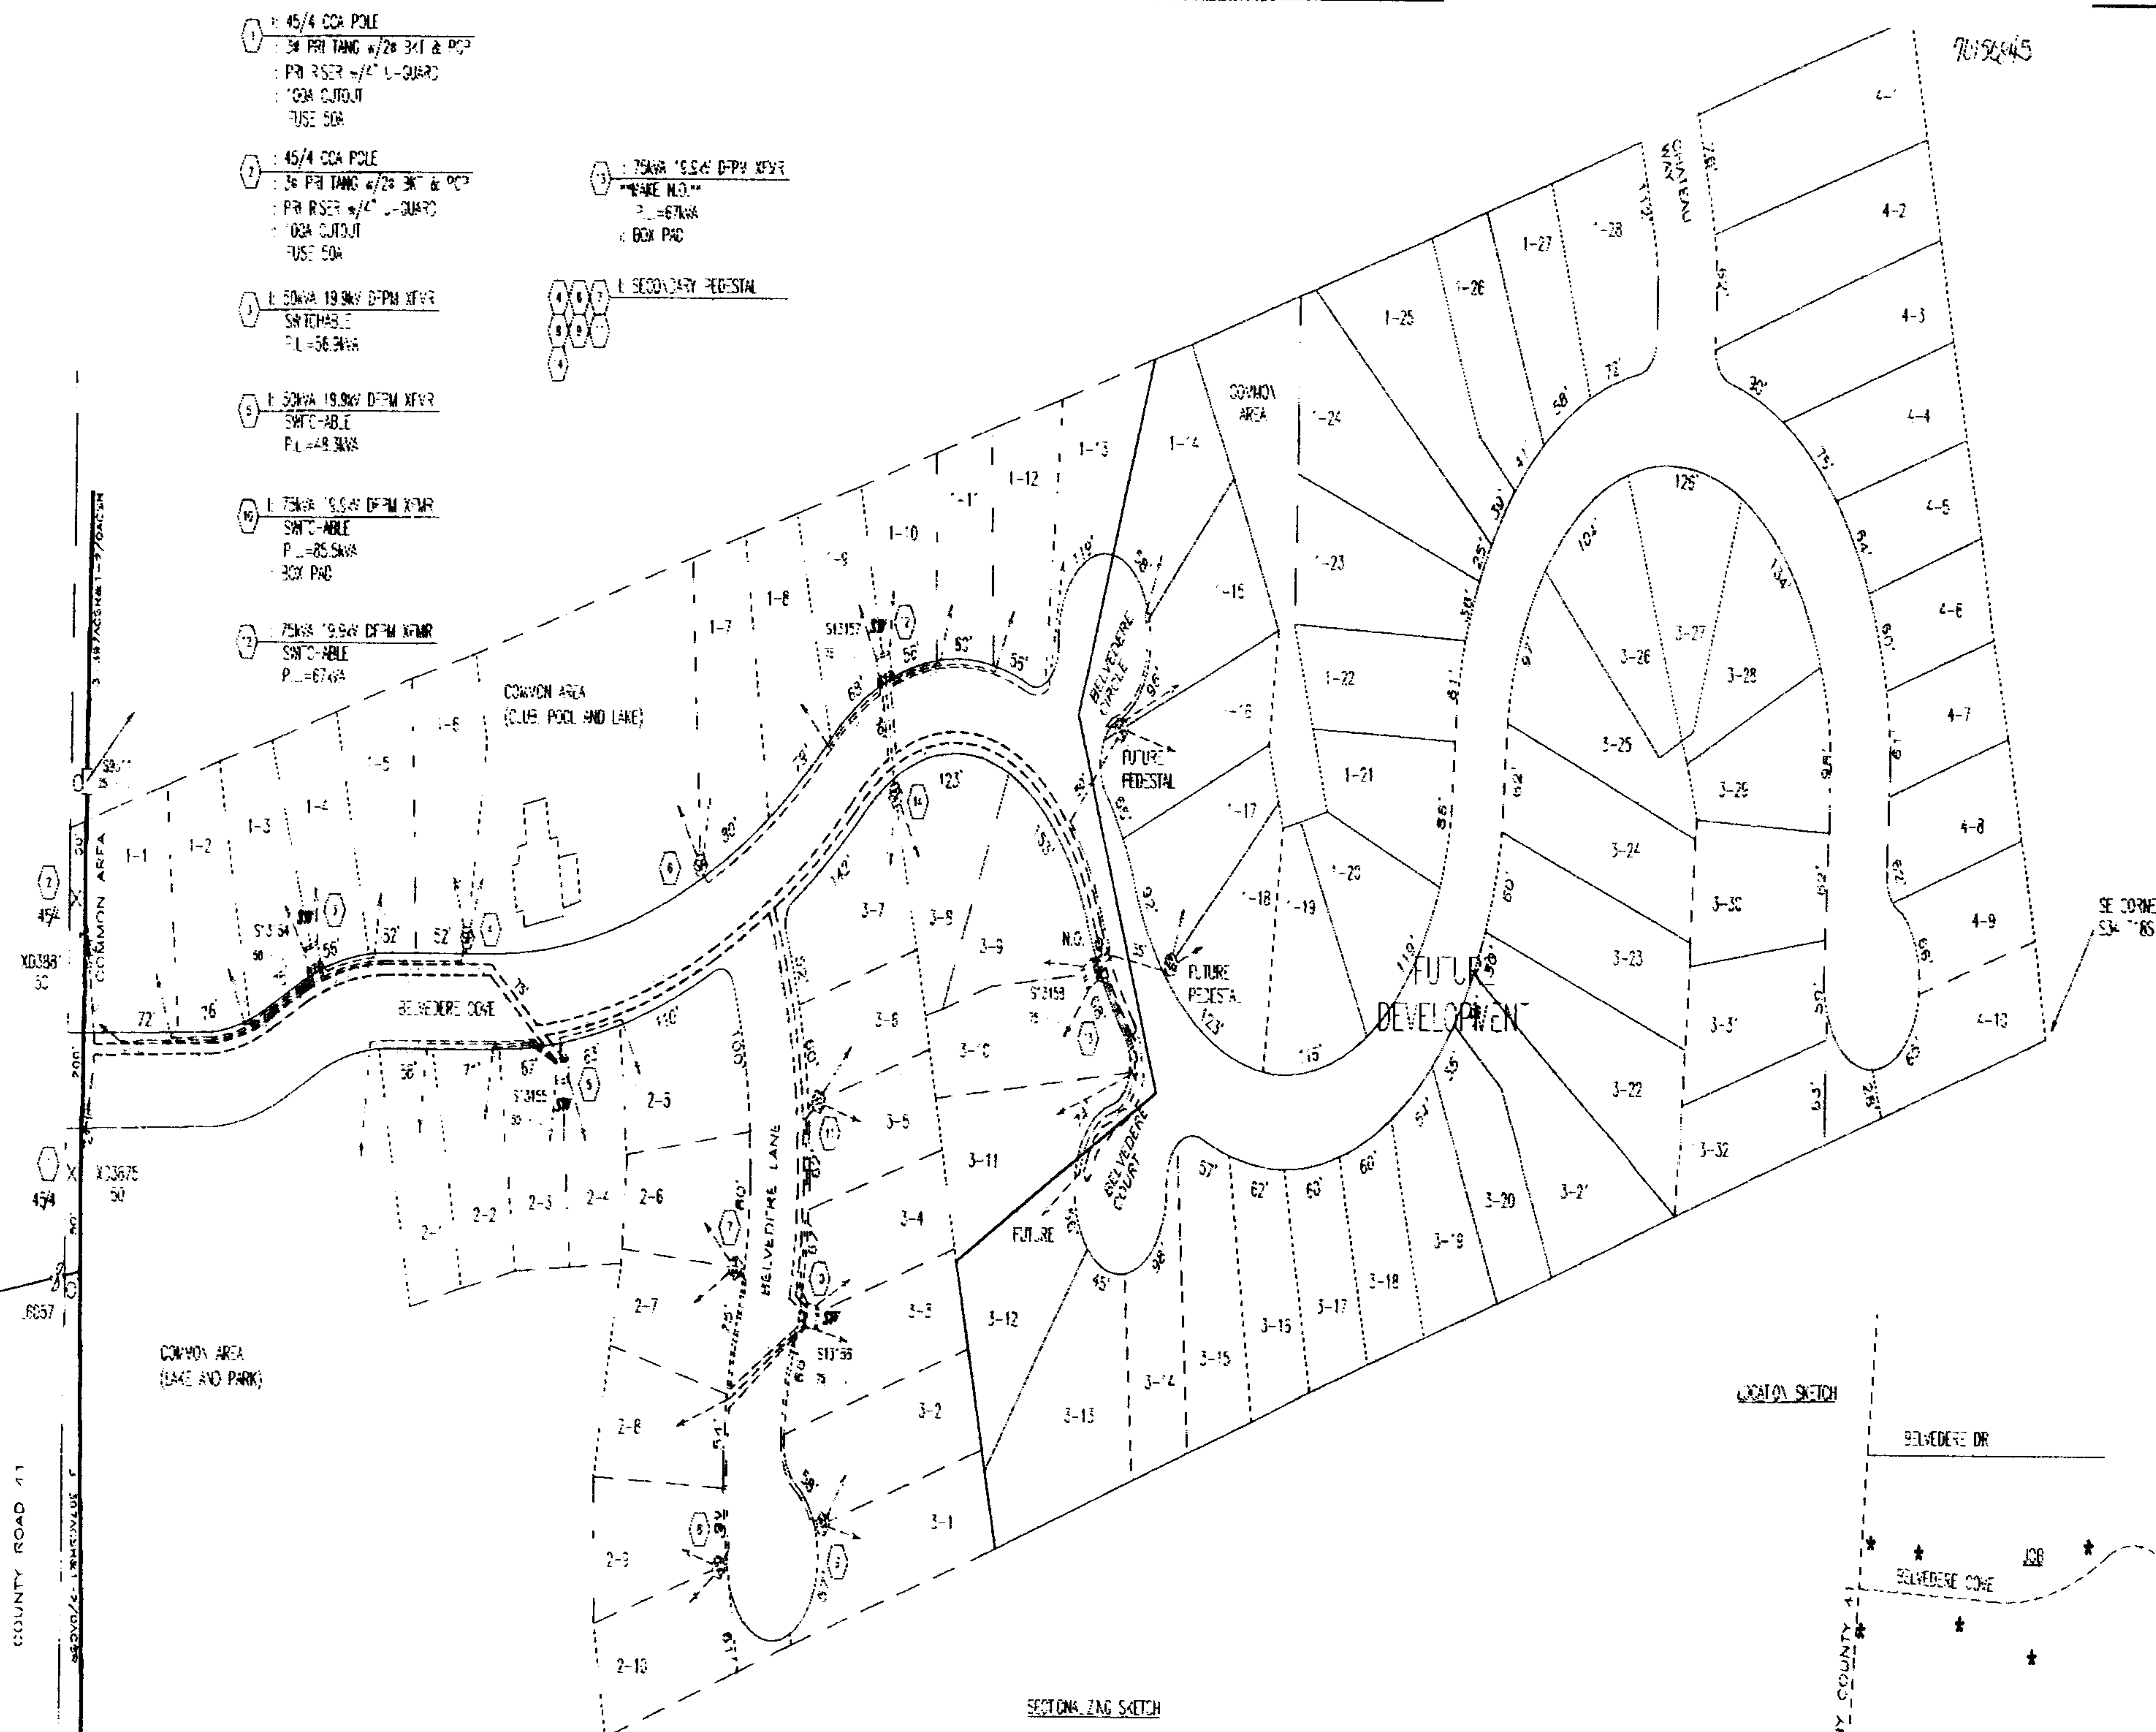

# NOTES:

1. RISER LOADING BASED ON DATA PER LOT.
2. TRANSFORMER LOADING BASED ON 120, 27 & 45 A/C.
3. FUSE RATED ON 45 & 45 A/C.
4. PRIMARY CABLE TO BE 21/0 ALUM 34.5KV CABLE DIRECT BURIED 42" BELOW GROUND.
5. ALL ROAD CROSSINGS WILL COMPLY WITH SHELBY COUNTY'S REQUIREMENTS.
6. ALL SECONDARY FROM TRANSFORMER TO SECONDARY PEDISTAL TO BE 1" 45/4 & 2" 45/4 ALUM 100KV CABLE DIRECT BURIED.
7. ALL OTHER CABLE TO BE 1" 45/4 & 2" 45/4 ALUM 100KV CABLE DIRECT BURIED.
8. AVERAGE SERVICE LENGTH 5.50'.
9. MAXIMUM VOLTAGE DROP CALCULATED AT LOT 1-7 IS 1.68%.
10. MAXIMUM FUSE RATED AT LOT 1-7 IS 3.12%.
11. APOD CONTRACTOR TO PERFORM ALL TRENCHING, INSTALL ALL CABLE, CONDUITS, TRANSFORMER PADS, AND GROUND RODS.

FOR EMERGENCY LIVE WORK


OBTAIN ALL WORK PERMIT #

SUBSTATION DOUBLE OAK VIN DS.

FEEDER #2 BREAKER #22115

## RISER LOADING

SWITCH #	EXISTING	PROPOSED	FUTURE	TOTAL	EMERGENCY
XD-804	0	78A	80A	158A	340A
XD-805	0	100A	90A	190A	340A

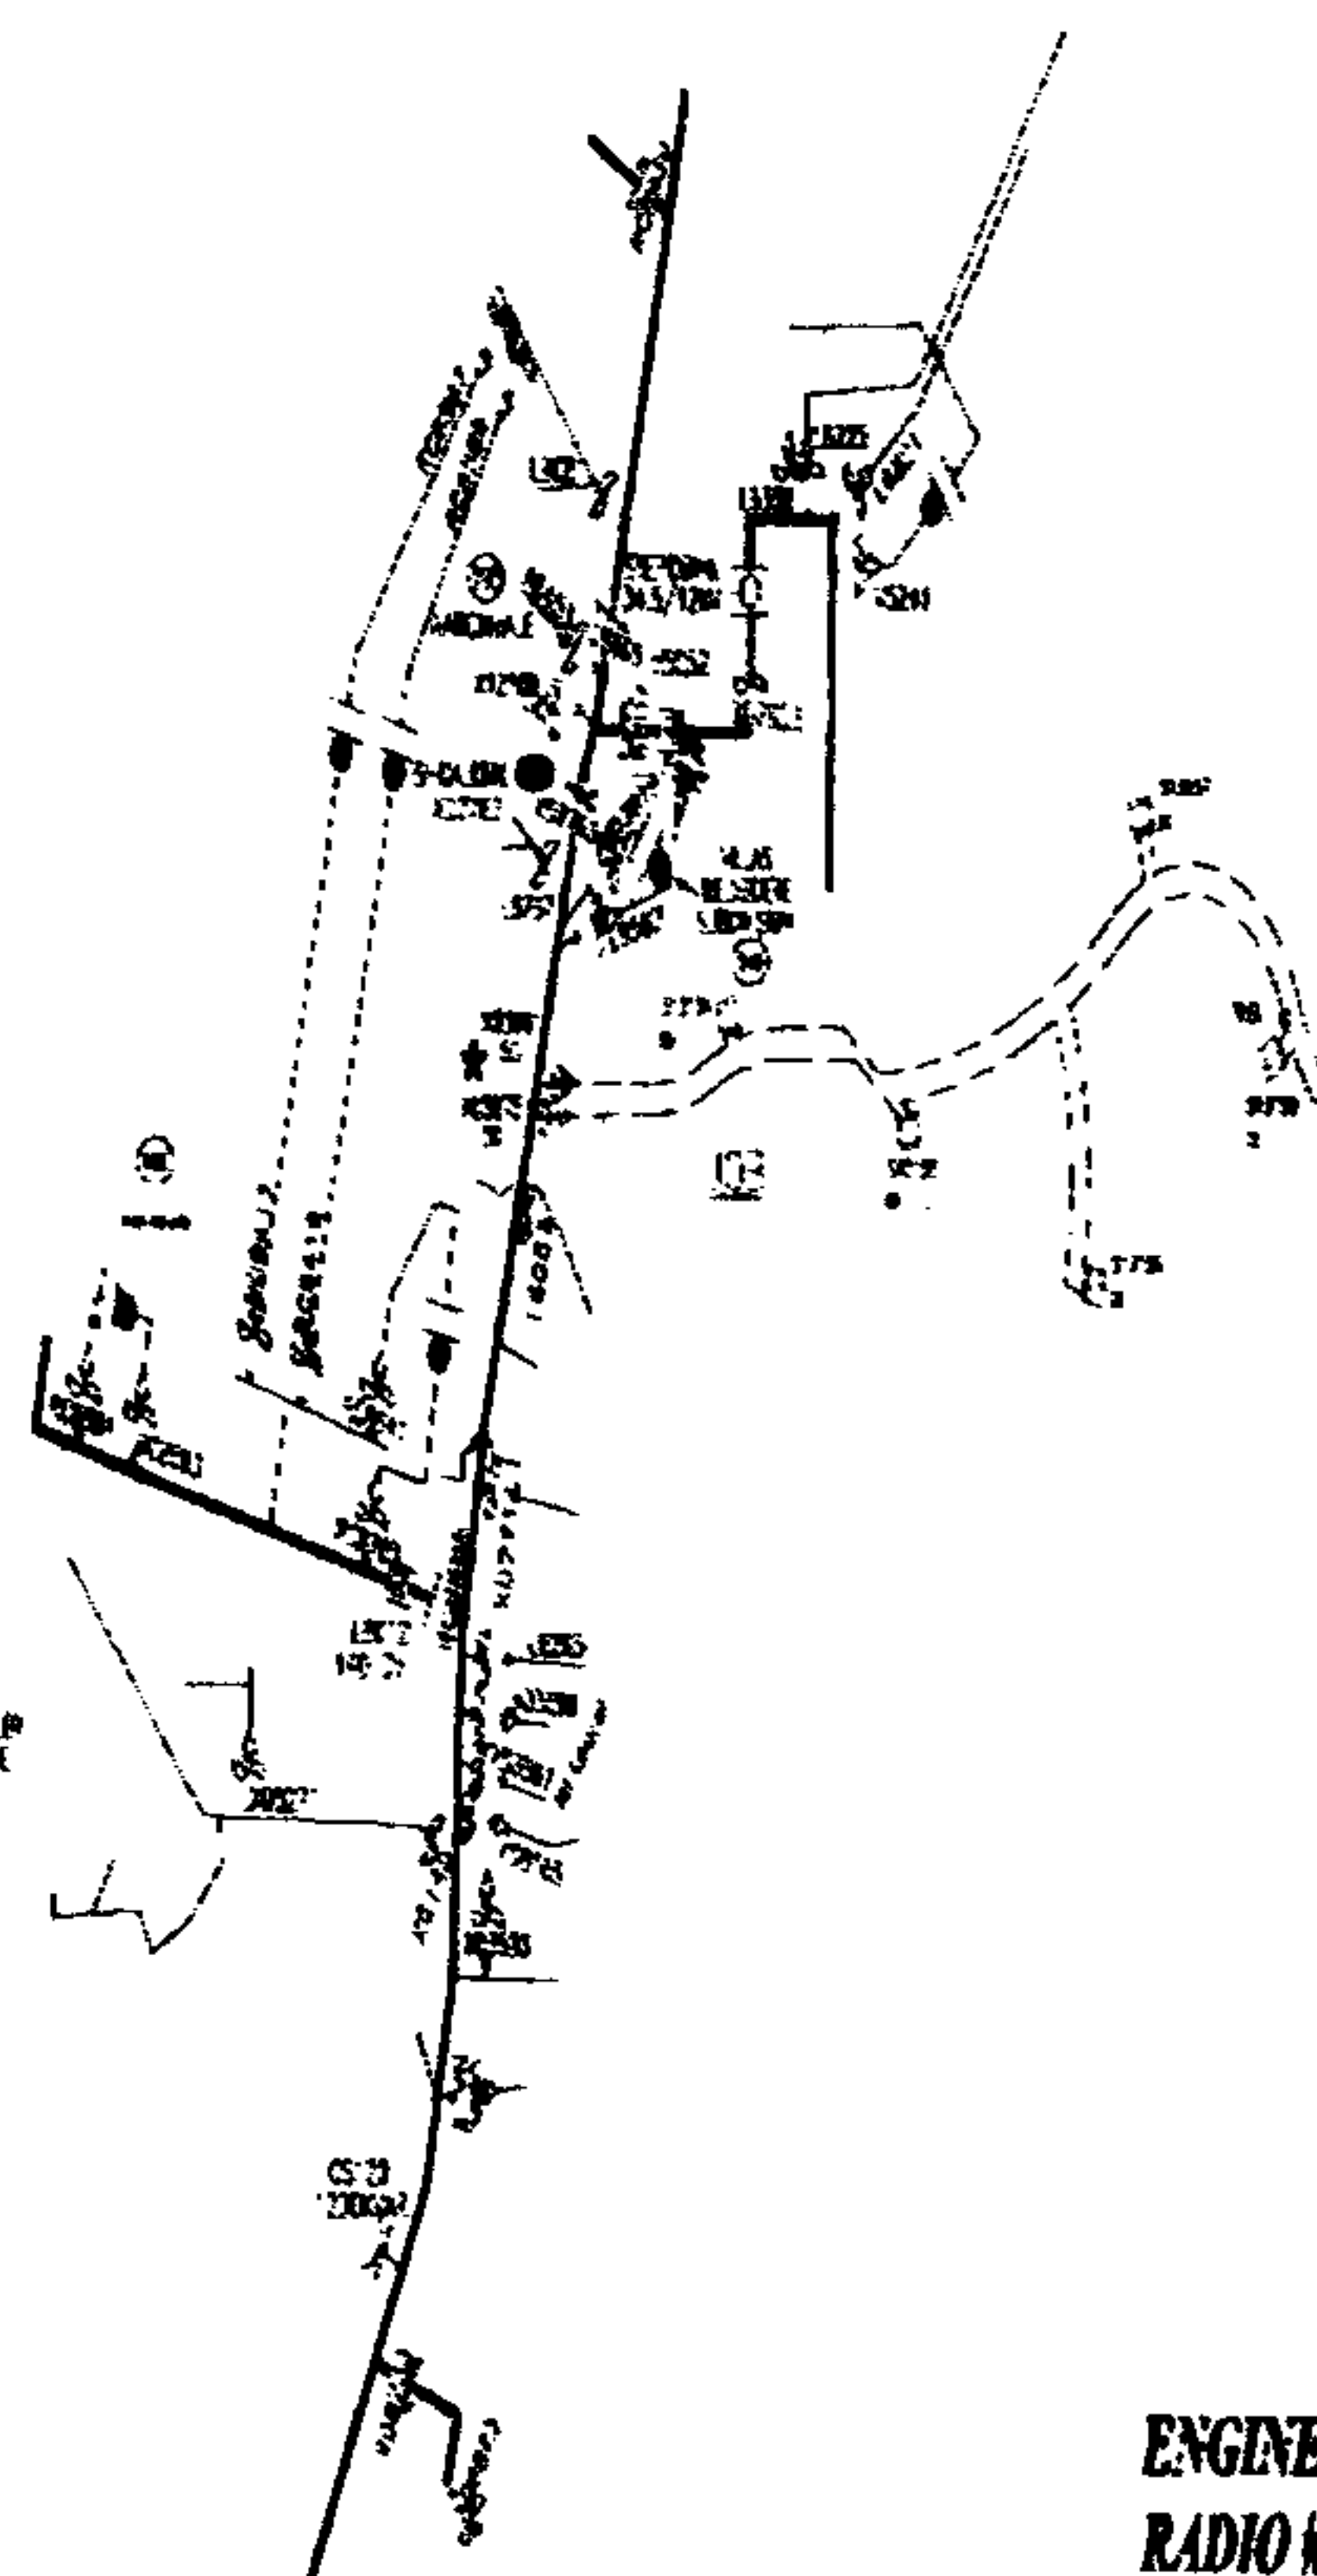

ENGINEER: JAMEELA BELYEU  
RADIO #10101

0 100 200

PLAN SCALE

OWN:	COUNTY SHELBY
VAP REF:	SEC-34, P-185, R-2
DRAWN BY/LO:	EMGR J. BELYEU
DATE:	11/05/04
APPROVED:	DATE:
APPROVED:	DATE:

ANY CONSTRUCTION FIELD CHANGES ARE SHOWN IN RED ON THIS PLAN

ALABAMA POWER COMP	
JOB: POWER DELIVERY - BRANCH-AV	
DATA: V.LAS BELVEDERE	
P-HASE 1	
SCALE: 1" = 100'	PLOTTED: 01-11
SHEET 1 OF 1 SHEETS	SUPERSEDES

C-61700-03