

EASEMENT - DISTRIBUTION FACILITIES
Metes and Bounds)

TO BE RECORDED: YES X NO

This instrument prepared by:

Larry D. Smith

Alabama Power Company

P. O. Box 2641

Birmingham, Alabama 35291

STATE OF ALABAMA

COUNTY OF Shelby

TAX ID #

W.E. No. 61700-00-0370-600

Parcel No. 70184885

Transformer No.

I. **GRANT** KNOW ALL MEN BY THESE PRESENTS, That Shelby Land & Development, LLC

Grantors (s), (the "Grantor", whether one or more) for and in consideration of One and No/100 (\$1.00) and other good and valuable consideration, to Grantor in hand delivered by Alabama Power Company, a corporation, the receipt and sufficiency of which are hereby acknowledged, does hereby grant to Alabama Power Company, its successors and assigns (the "Company"), the easements, rights and privileges described and designated in Section B below.

B. **RIGHTS** The easements, rights and privileges granted hereby are as follows:

- Overhead and/or Underground.** The right from time to time to construct, install, operate and maintain, upon, over, under and across the Property described in Section C below, along a route to be selected by the Company which is generally shown on the Company's final location drawing (which shows the general location of underground Facilities, if any, by indicating an area not greater than ten feet (10') in width), all poles, towers, wires, conduits, fiber optics, cables, trans closures, transformers, anchors, guy wires and other Facilities useful or necessary in connection therewith (collectively, "Facilities"), for the overhead and/or underground transmission and distribution of electric power, and also the right to clear and keep clear a strip of land extending five feet (5') to either side of the center line of underground Facilities and fifteen feet (15') to either side of the center line of overhead Facilities; further, the right in the future to install and utilize intermediate poles in line for overhead Facilities and the right to trim and cut and keep trimmed and cut all dead, weak, leaning or dangerous trees or limbs outside of the thirty foot (30') strip for overhead Facilities that, in the sole opinion of the Company, might now or may hereafter endanger, interfere with or fall upon any of the overhead Facilities.
- Line Clearing.** The right to trim and cut and keep trimmed and cut all dead, weak, leaning or dangerous trees or limbs that, in the sole opinion of the Company, might now or may hereafter endanger, interfere with or fall upon the electric transmission or distribution lines, poles, towers or other Facilities now or hereafter located adjacent to the Property described in Section C below along a route to be selected by the Company generally shown on the Company's final location drawing, and also the right to clear and keep clear all trees, undergrowth, and other obstructions on property in which Grantor has an interest within fifteen feet (15') of the center line of the lines of such poles, towers or other Facilities.
- Guy Wires and Anchors.** The right to implant, install and maintain anchor(s) of concrete, metal or other material on and under the Property described in Section C below, and to construct, extend and maintain guy wires from such anchor(s) to structures now or hereafter erected adjacent to such Property or property adjacent thereto (collectively, "Guy Wire Facilities") along a route to be selected by the Company generally shown on the Company's final location drawing; and also the right to trim and cut and keep trimmed and cut all dead, weak, leaning or dangerous trees or limbs that, in the sole opinion of the Company, might now or may hereafter endanger, interfere with or fall upon any of the Guy Wire Facilities.

Grantor hereby grants to the Company all easements, rights and privileges necessary or convenient for the full enjoyment and use thereof, including without limitation the right of ingress and egress to and from the Facilities and Guy Wire Facilities, as applicable, and the right to excavate for installation, replacement, repair and removal thereof; and also the right to cut, remove and otherwise keep clear any and all structures, obstructions or obstacles of whatever character, on, under and above said Facilities and Guy Wire Facilities, as applicable.

PROPERTY DESCRIPTION The easements, rights and privileges granted hereby shall apply to, and the word "Property" as used in this instrument shall mean, the following described real property situated in Shelby County, Alabama (the "Property"):

Lot # 2, according to the Survey of Airport Commons, as recorded in Map Book 36, Page 139 in the office of the Judge of Probate of Shelby County, Alabama. Located in the S 1/2 of the NW 1/4 of Section 32, Township 21 South, Range 2 West.

ADDITIONAL PROVISIONS. In the event it becomes necessary or desirable for the Company to move any of the Facilities in connection with the construction or improvement of any public road or highway in proximity to the Facilities, Grantor hereby grants to the Company the right to relocate the Facilities and, as to such relocated Facilities, to exercise the rights granted above; provided, however, the Company shall not relocate the Facilities on the Property at a distance greater than ten feet (10') outside the boundary of the right of way of any such public road or highway as established or re-established from time to time. This grant and agreement shall be binding on and shall inure to the benefit of Grantor, the Company and each of their respective heirs, personal representatives, successors and assigns and the words "Company" and "Grantor" as used in this instrument shall be deemed to include the heirs, personal representatives, successors and assigns of such parties.

TO HAVE AND TO HOLD the same to the Company, its successors and assigns, forever.

IN WITNESS WHEREOF, the undersigned Grantor ~~(X)~~ has/have set his/her/their hand(s) and seal(s) this the 29th day of November, 2006.

Witness

(Grantor)

(SEAL)

Witness


(Grantor)

(SEAL)

Witness

By: [Signature]
As: Member

(SEAL)

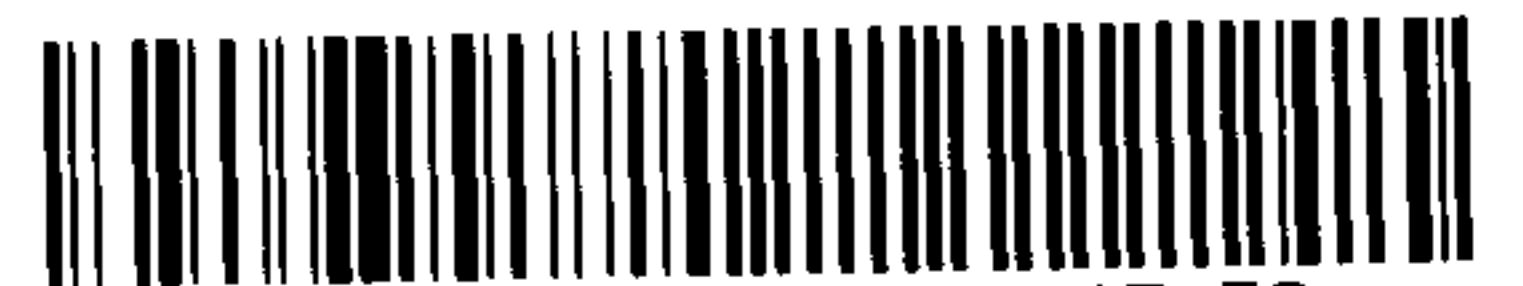

20070517000231010 1/3 \$17.50
Shelby Cnty Judge of Probate, AL
05/17/2007 03:19:26PM FILED/CERT

WITNESS WHEREOF, the said Grantor, has caused this instrument to be executed by _____ its authorized representative, as of the _____ day of _____, 20_____.

TEST (if corporation) or WITNESS:

(Grantor - Name of Corporation/Partnership/LLC)

y: _____
s: _____

By: _____ (SEAL)
Its: _____

[indicate President, General Partner, Member, etc.]

INDIVIDUAL NOTARIES

TATE OF ALABAMA }
OUNTY OF _____ }

I, the undersigned, a Notary Public, in and for said County in said State, hereby certify that _____ whose name(s) is/are signed to the foregoing instrument and who is/are known to me, acknowledged before me on this day that being informed of the contents of the instrument, he/she/they executed the same voluntarily, on the day the same bears date.

Given under my hand and official seal this the _____ day of _____, _____.

[SEAL]

Notary Public
My commission expires: _____

TATE OF ALABAMA }
OUNTY OF _____ }

I, the undersigned, a Notary Public, in and for said County in said State, hereby certify that _____ whose name(s) is/are signed to the foregoing instrument and who is/are known to me, acknowledged before me on this day that being informed of the contents of the instrument, he/she/they executed the same voluntarily, on the day the same bears date.

Given under my hand and official seal this the _____ day of _____, _____.

[SEAL]

Notary Public
My commission expires: _____

TRUSTEE/CORPORATION/PARTNERSHIP/LLC NOTARY

TATE OF ALABAMA }
OUNTY OF Shelby }

I, the undersigned, a Notary Public, in and for said County in said State, hereby certify that Ken Underwood whose name as Managing Member of Shelby Land Development, LLC a _____ [as _____], is signed to the foregoing instrument, and who is known to me, acknowledged before me on this day that being informed of the contents of the instrument, he/she, as such Managing Member and with full authority, executed the same voluntarily for and as the _____ of said _____ [acting in such capacity as aforesaid].

Given under my hand and official seal, this the 29th day of November, 2006.

[SEAL]

Larry D. Smith
Notary Public
My commission expires: 2-6-10

For Alabama Power Company Corporate Real Estate Department Use Only

facilities on Grantor: _____

Station to Station: Montgomery (AL)

Shelby County, AL 05/17/2007
State of Alabama

Deed Tax: \$.50

20070517000231010 2/3 \$17.50
Shelby Cnty Judge of Probate, AL
05/17/2007 03:19:26PM FILED/CERT

CONSTRUCTION COMPLETE:

ANY CONSTRUCTION FIELD CHANGES
ARE SHOWN IN RED ON THIS PRINT.

ALABAMA POWER COMPANY

JOB POWER DELIVERY - BIRMINGHAM SOUTH

DETAIL AIRPORT COMMONS

GEORGE ROY PKWY & CO RD 12

SCALE 1" = 40'

PLOTTED 08-16-06

SHEET 1 OF 1 SHEETS

SUPERSEDES

C-61700-00-03706


DEVELOPER:
KEN UNDERWOOD
(205) 369-4689

TERRY GALLOPS
369-4689

ENGINEER: BOB JORDAN
RADIO #11493

REvised: 08/09/06 SLH

CUSTOMER TO INSTALL 5" SCH 40 CONDUIT
 @ 48" BELOW GRADE PER APCO SPECS

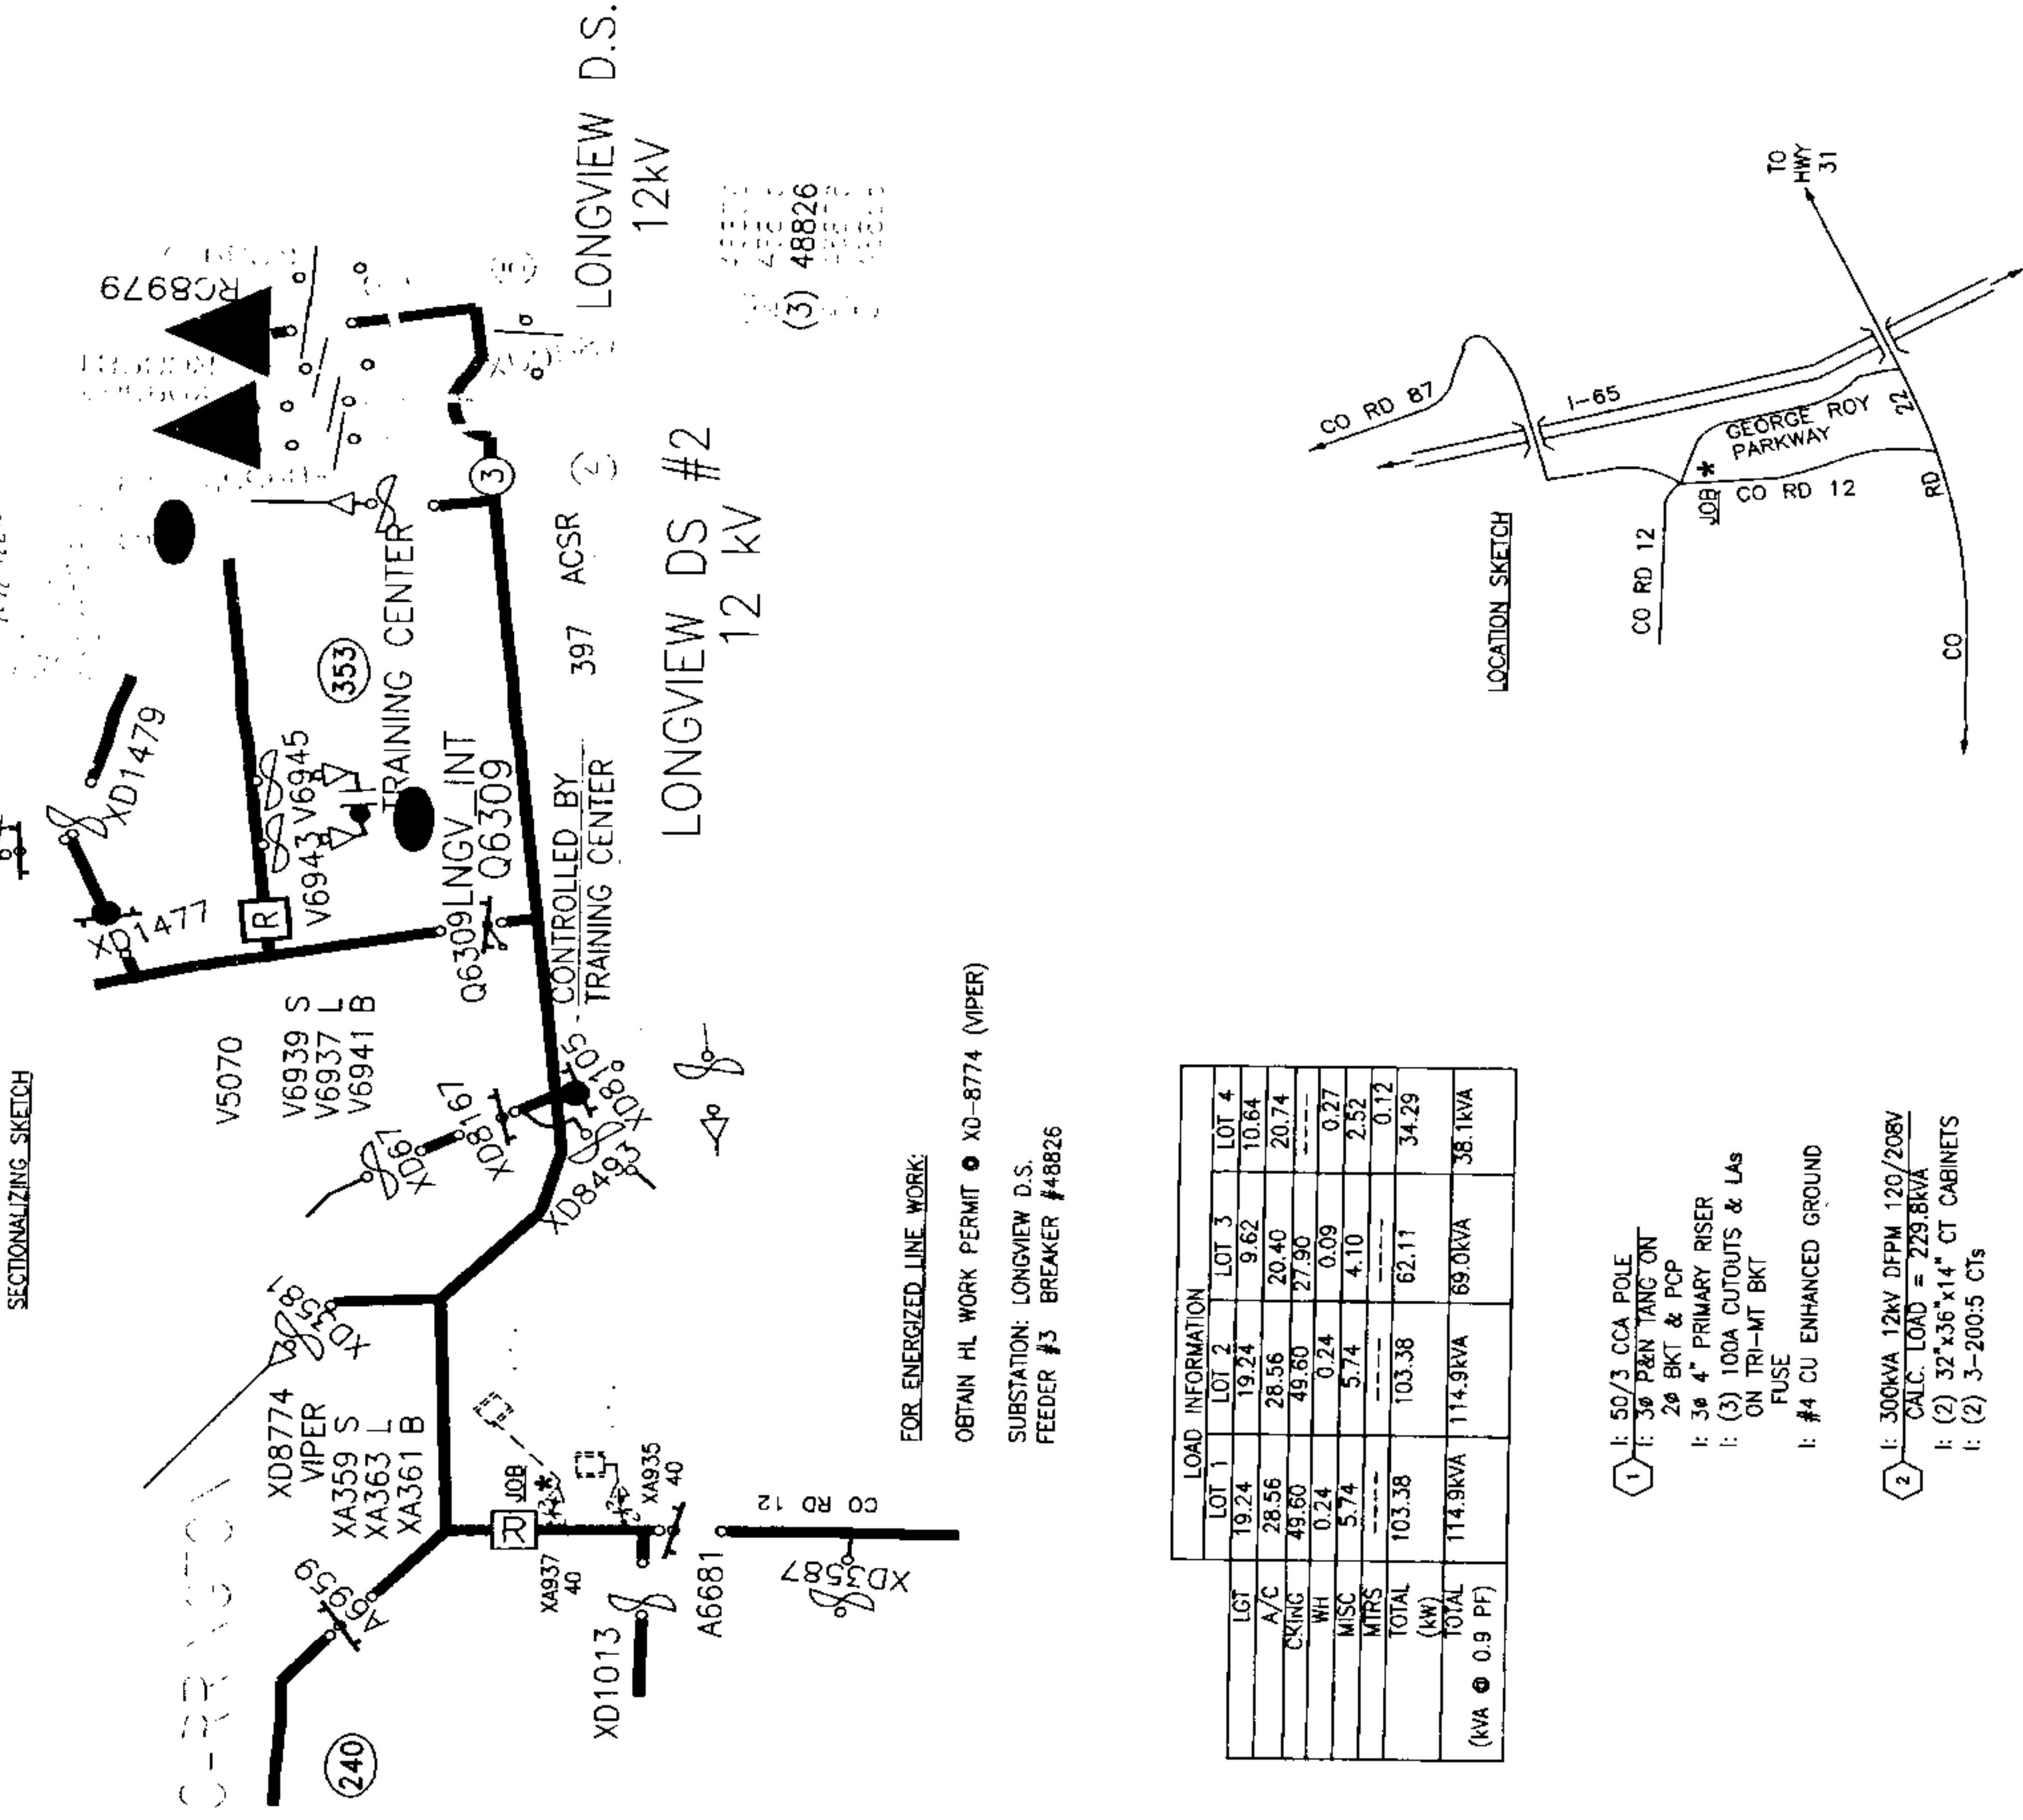

LOAD INFORMATION					
	LOT 1	LOT 2	LOT 3	LOT 4	
LOT	19.24	19.24	9.62	10.64	
A/C	28.56	28.56	20.40	20.74	
CHNG	49.50	49.50	27.90	---	
WH	0.24	0.24	0.09	0.27	
MISC	5.74	5.74	4.10	2.52	
MTRS	---	---	---	0.12	
TOTAL	103.38	103.38	62.11	34.29	
(kW)					
TOTAL	114.9kVA	114.9kVA	69.9kVA	38.1kVA	
(kVA @ 0.9 PF)					

1: 50/3 CCA POLE
1: 3Ø P&N TANG ON
2Ø BKT & PCP
1: 3Ø 4" PRIMARY RISER
1: (3) 100A CUTOUTS & LAS
ON TRI-MT BKT
FUSE
1: #4 CU ENHANCED GROUND

2 I: 300KVA 12KV DPFM 120/208V
CALC. LOAD = 229.8KVA
I: (2) 32"x36"x14" CT CABINETS
I: (2) 3-200.5 CTs

3 I: 150KVA 12kV DFPN 120/208V
CALC. LOAD = 107.1KVA
I: (2) 32"x36"x14" CT CABINETS
I: (2) 3-200.5 CTs

1: 3Ø 4" PRIMARY RISER
1: (3) 100A CUTOUPS & LAS
ON TRI-MT BKT
FUSE
1: #4 CU ENHANCED GROUND

SECTIONALIZING SKETCH

FOR ENERGIZED LINE WORK:
OBTAIN HL WORK PERMIT • XD-8774 (VIPER)
SUBSTATION: LONGVIEW D.S.
FEEDER #3 BREAKER #48826

DATE: _____

LOCATION SKETCH

617000003706z.dwg

20070517000231010 3/3 \$17.50
Shelby Cnty Judge of Probate, AL
05/17/2007 03:19:26PM FILED/CERT