

EASEMENT - UNDERGROUND

\$ 500.00

Source of Title:

STATE OF ALABAMA

Deed Book _____, Page _____

COUNTY OF SHELBY

W.E. No. A617306AH11

APC Parcel No. 70242040

Transformer No. **S-17913**

This instrument prepared by: BILL CHILDRESS

Alabama Power Company
P.O. Box 2641
Birmingham, Alabama 35291



20110920000278550 1/3 \$18.50
Shelby Cnty Judge of Probate, AL
09/20/2011 01:17:43 PM FILED/CERT

Shelby County, AL 09/20/2011
State of Alabama
Deed Tax: \$.50

KNOW ALL MEN BY THESE PRESENTS, That Investment Associates, LLC, an Alabama limited liability company

as grantor(s), (the "Grantor", whether one or more) for and in consideration of One and No/100 Dollar (\$1.00) and other good and valuable consideration paid to Grantor in hand by Alabama Power Company, a corporation, the receipt and sufficiency of which are hereby acknowledged, does hereby grant to Alabama Power Company, its successors and assigns (the "Company"), the easements, rights and privileges described below.

The right from time to time to construct, install, operate and maintain upon, under and across the Property described below, all wires, cables, trans closures, transformers, conduits, fiber optics, communication lines and other facilities useful or necessary in connection therewith (collectively, the "Facilities"), for the underground transmission and distribution of electric power and communications, along a route selected by the Company which is generally shown on the Company's drawing attached hereto and made a part hereof and which is to be determined by the locations in which the Company's Facilities are installed, such drawing showing the general location of underground facilities in an area ten feet (10') in width and also the right to clear and keep clear a strip of land extending five feet (5') from each side of said Facilities. Grantor hereby grants to the Company all easements, rights and privileges necessary or convenient for the full enjoyment and use thereof, including without limitation the right of ingress and egress to and from the Facilities and the right to excavate for installation, replacement, repair and removal thereof; and also the right to cut, remove and otherwise keep clear any and all structures, obstructions or obstacles of whatever character, on, under, adjacent to, and above said Facilities.

The easements, rights and privileges granted hereby shall apply to, and the word "Property" as used in this instrument shall mean, the following real property situated in SHELBY County, Alabama (the "Property"):

A parcel of land located in the NE¼ of the NW¼ of Section 1, Township 19 South, Range 2 West, more particularly described in Deed Record 20060411000166620, dated April 11, 2006, in the office of the Judge of Probate, Shelby County, Alabama.

In the event it becomes necessary or desirable for the Company from time to time to move any of the Facilities in connection with the construction or improvement of any public road or highway in proximity to the Facilities, Grantor hereby grants to the Company the right to relocate the Facilities and, as to such relocated Facilities, to exercise the rights granted above; provided, however, the Company shall not relocate the Facilities on the Property at a distance greater than ten feet (10') outside the boundary of the right of way of any such public road or highway as established or re-established from time to time. This grant and agreement shall be binding upon and shall inure to the benefit of Grantor, the Company and each of their respective heirs, personal representatives, successors and assigns and the words "Company" and "Grantor" as used in this instrument shall be deemed to include the heirs, personal representatives, successors and assigns of such parties.

TO HAVE AND TO HOLD the same to the said Company, its successors and assigns, forever.

IN WITNESS WHEREOF, the undersigned Grantor(s) has/have set his/her/their hand(s) and seal(s) this the _____ day of _____, 20____.

Witness

(Grantor) (SEAL)

Witness

(Grantor) (SEAL)

Witness

By: _____ (SEAL)

As: _____

For Alabama Power Company Corporate Real Estate Department Use Only

All facilities on Grantor: _____ Station to Station: sta 1+00 to sta 1+3

IN WITNESS WHEREOF, the said Grantor, has caused this instrument to be executed by Jonathan Belcher
its authorized representative, as of the 12th day of August, 2011.

ATTEST (if required) or WITNESS:

Investment Associates, LLC, an Alabama limited liability com
(Grantor - Name of Corporation/Partnership/LLC)

By: _____

By: [Signature] (SEAL)

Its: _____

Its: Member
[indicate President, General Partner, Member, etc.]

INDIVIDUAL NOTARIES

STATE OF ALABAMA

COUNTY OF _____

I, _____, a Notary Public, in and for said County in said State, hereby certify that _____
whose name(s) [as _____] is/are signed to the
foregoing instrument and who is/are known to me, acknowledged before me on this day that being informed of the contents of the instrument, he/she/they [in
such capacity as aforesaid] executed the same voluntarily.

Given under my hand and official seal this the _____ day of _____, 20____.

Notary Public

[SEAL]

My commission expires: _____

STATE OF ALABAMA

COUNTY OF _____

I, _____, a Notary Public, in and for said County in said State, hereby certify that _____
whose name(s) [as _____] is/are signed to the
foregoing instrument and who is/are known to me, acknowledged before me on this day that being informed of the contents of the instrument, he/she/they [in
such capacity as aforesaid] executed the same voluntarily.

Given under my hand and official seal this the _____ day of _____, 20____.

Notary Public

[SEAL]

My commission expires: _____

CORPORATION/PARTNERTNERSHIP/LLC NOTARY

STATE OF ALABAMA

COUNTY OF Shelby

I, Donna B. Coleman, a Notary Public, in and for said County in said State, hereby certify that Jonathan Belcher
whose name as member of Investment Associates LLC, a
_____, [acting in its capacity as member of _____]
is signed to the
foregoing instrument, and who is known to me, acknowledged before me on this day that, being informed of the contents of the instrument, he/she, as such
and with full authority, executed the same voluntarily, for and as the act of said
[acting in such capacity as aforesaid].

Given under my hand and official seal this the 12th day of August, 2011.


Donna B. Coleman
Notary Public

[SEAL]



My commission expires: 8-31-2014



20110920000278550 3/3 \$18.50
Shelby Cnty Judge of Probate, AL
09/20/2011 01:17:43 PM FILED/CERT

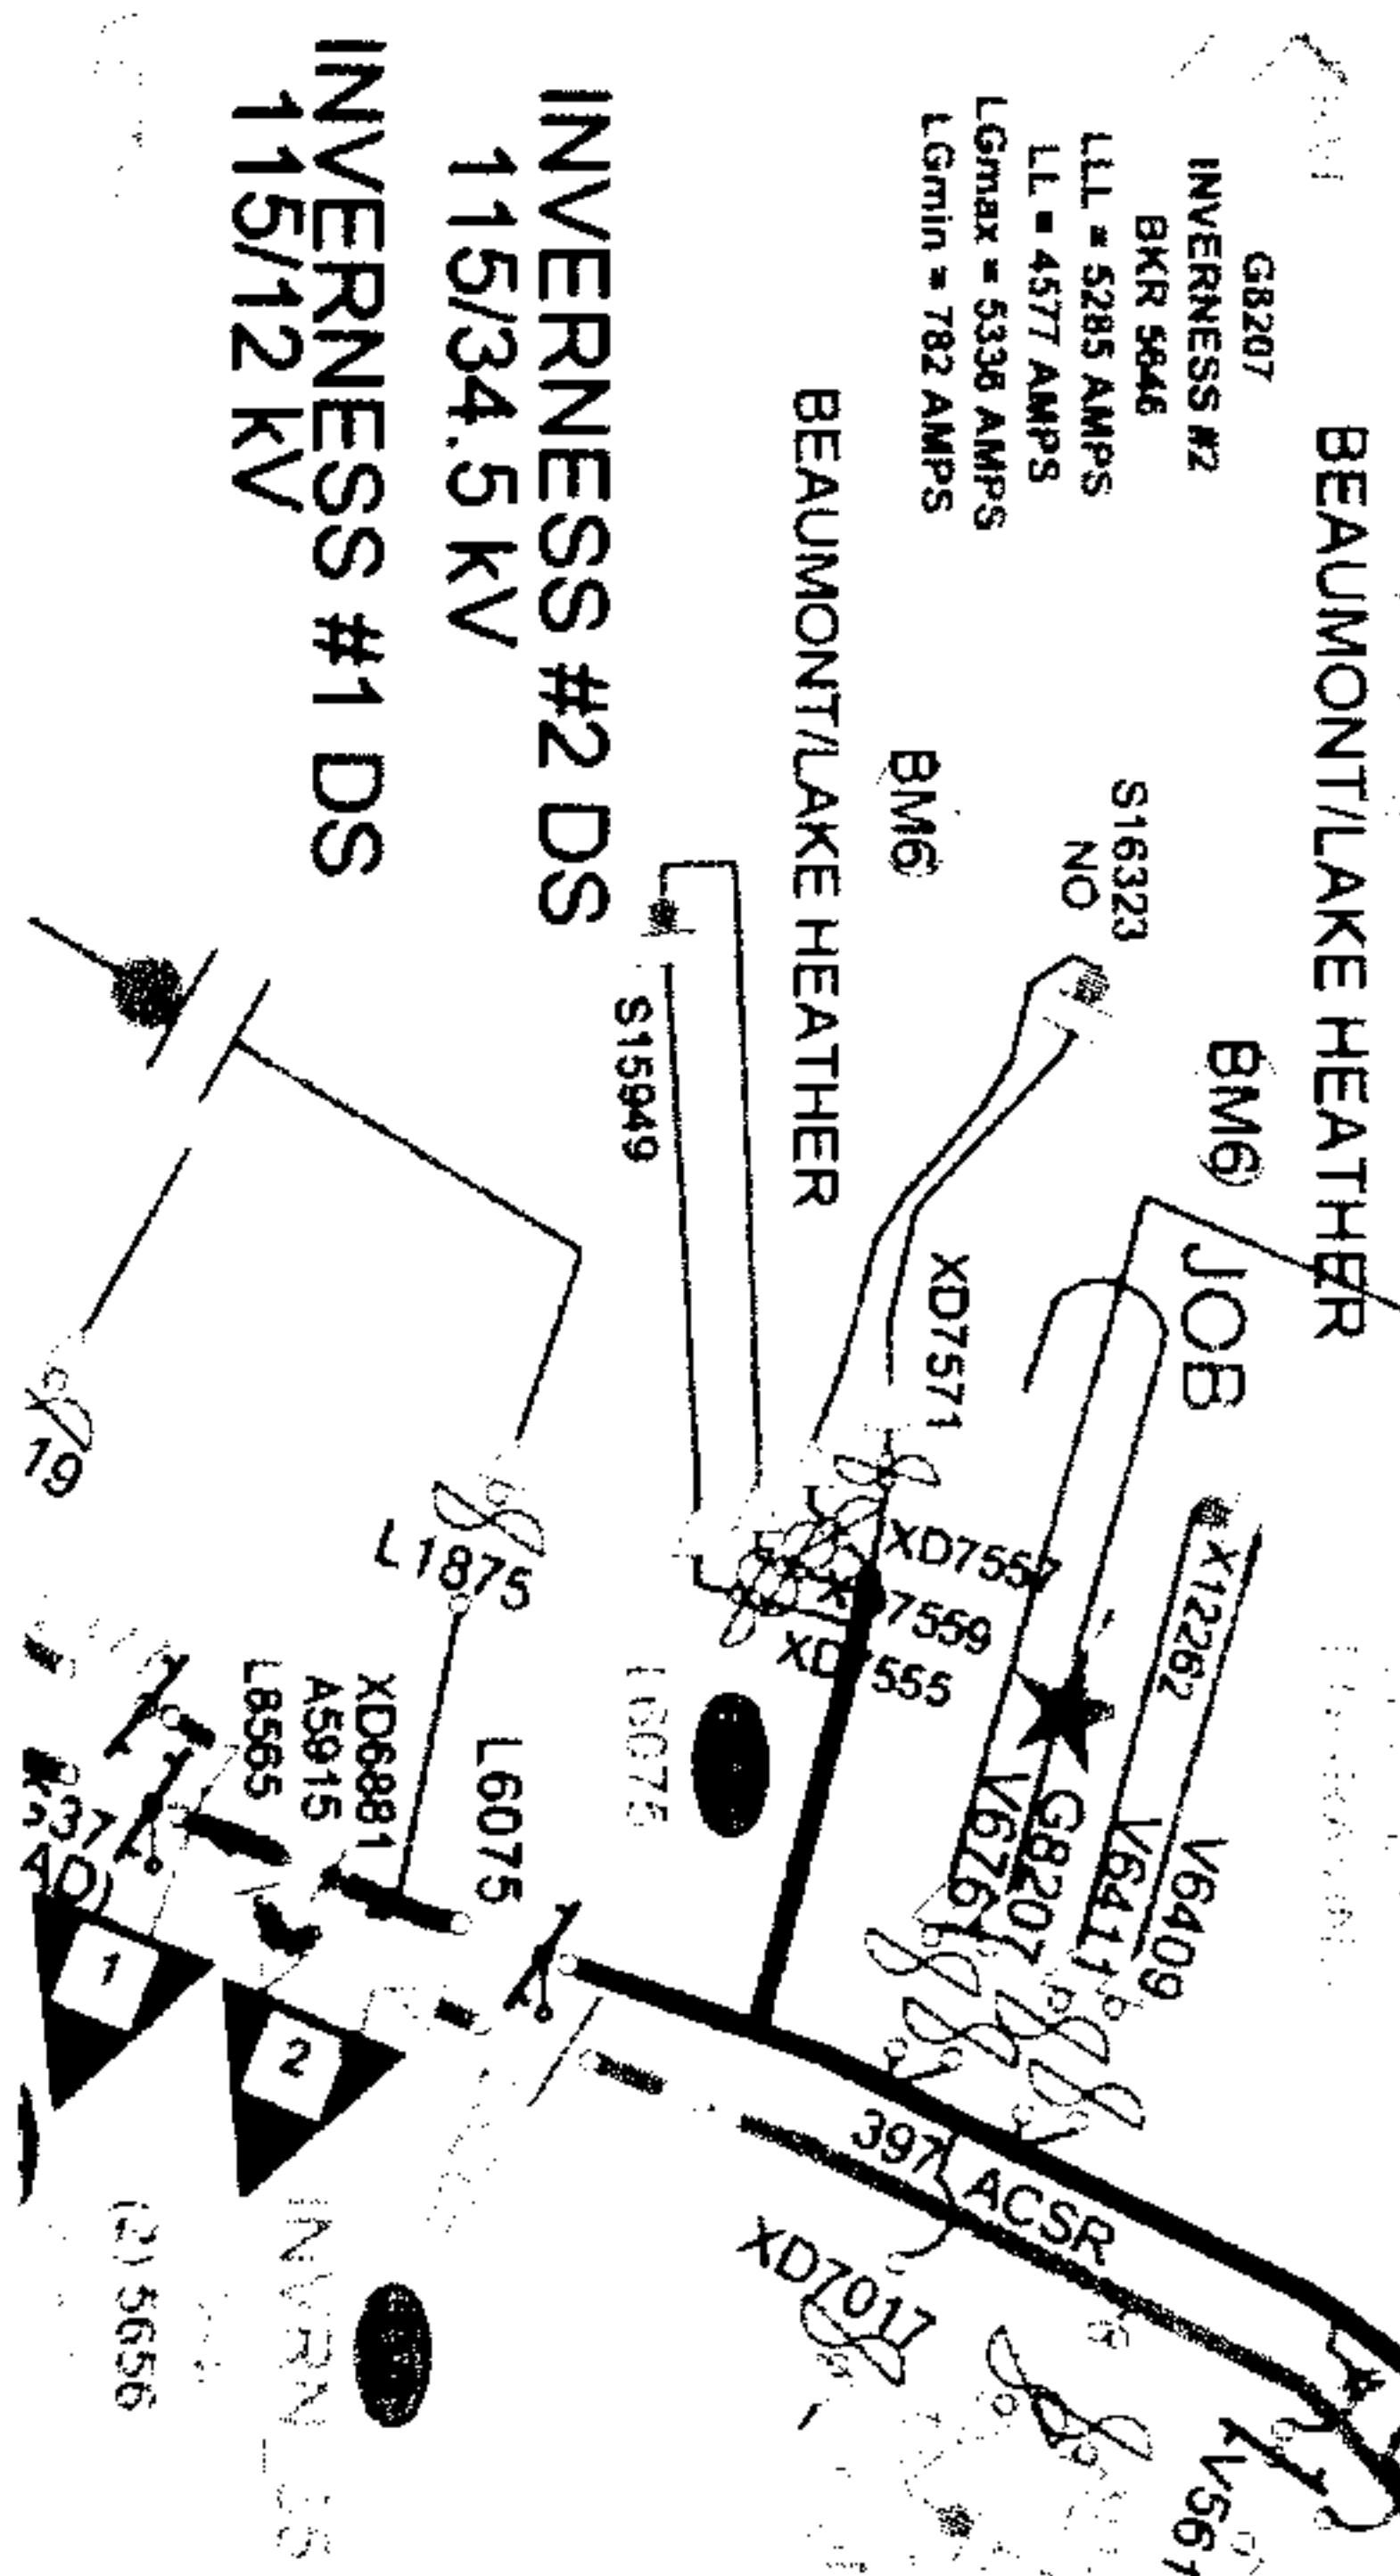

Job Received-8-9-11
Job Released-8-22-11

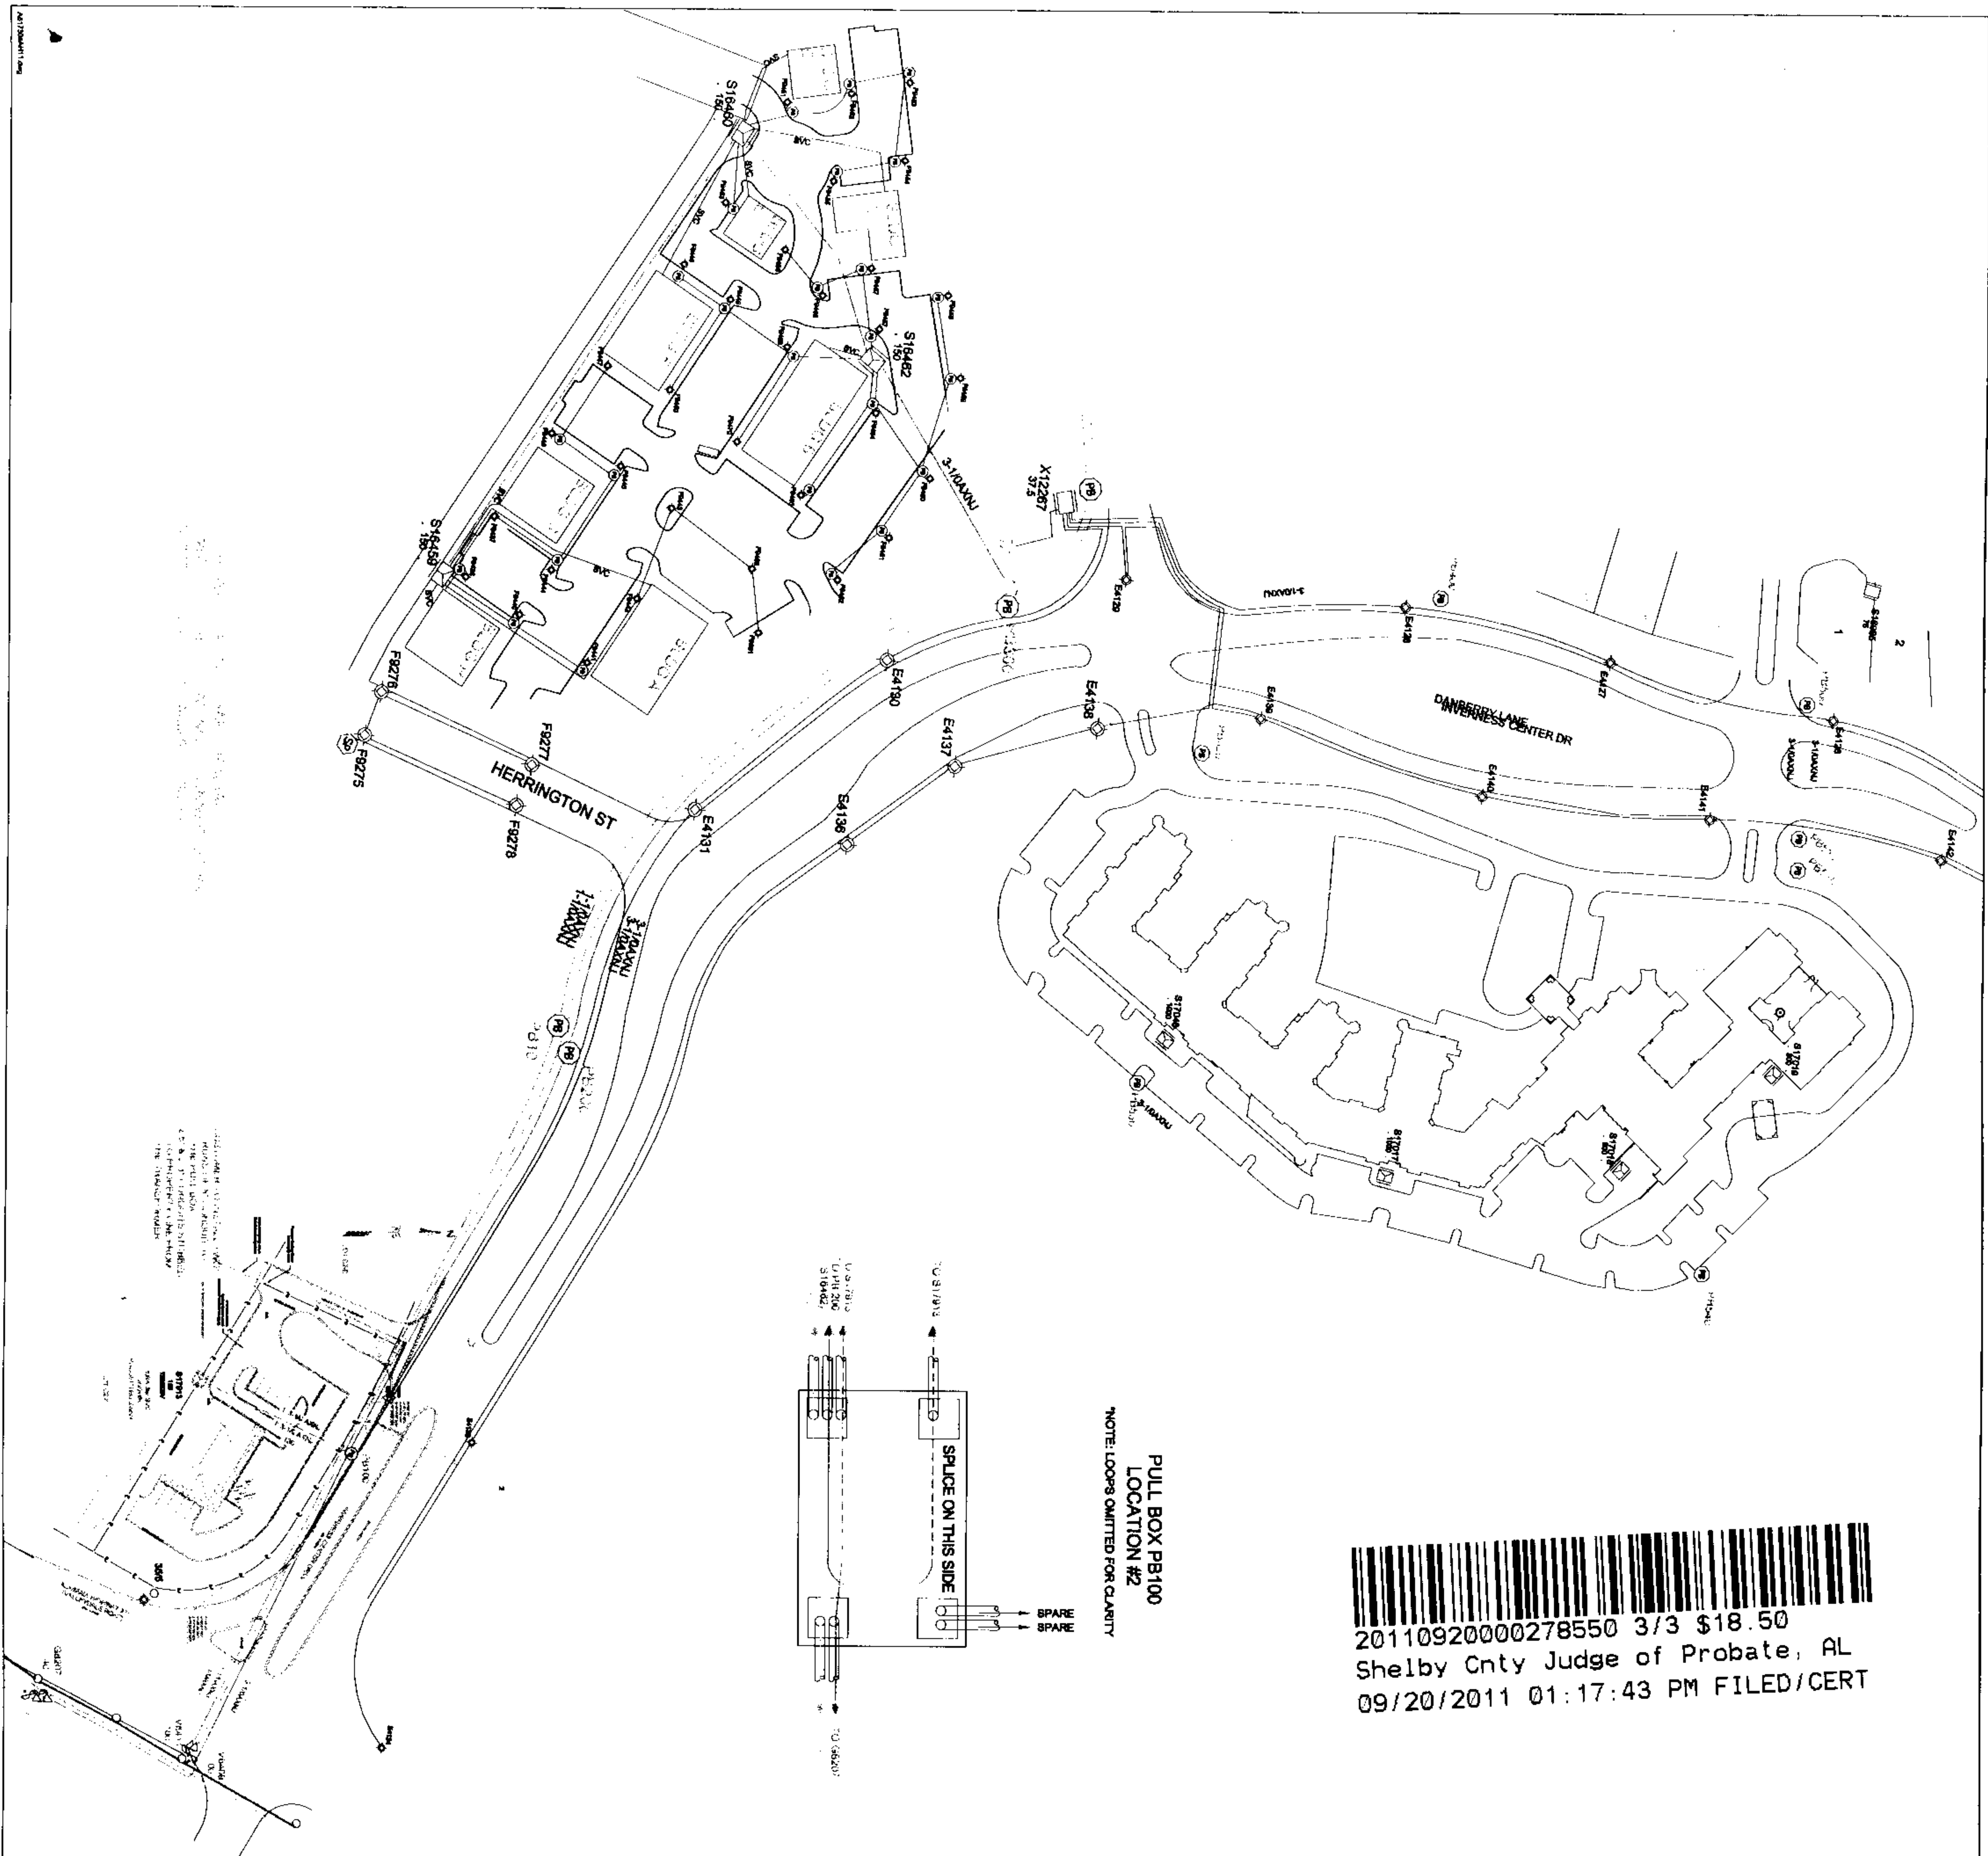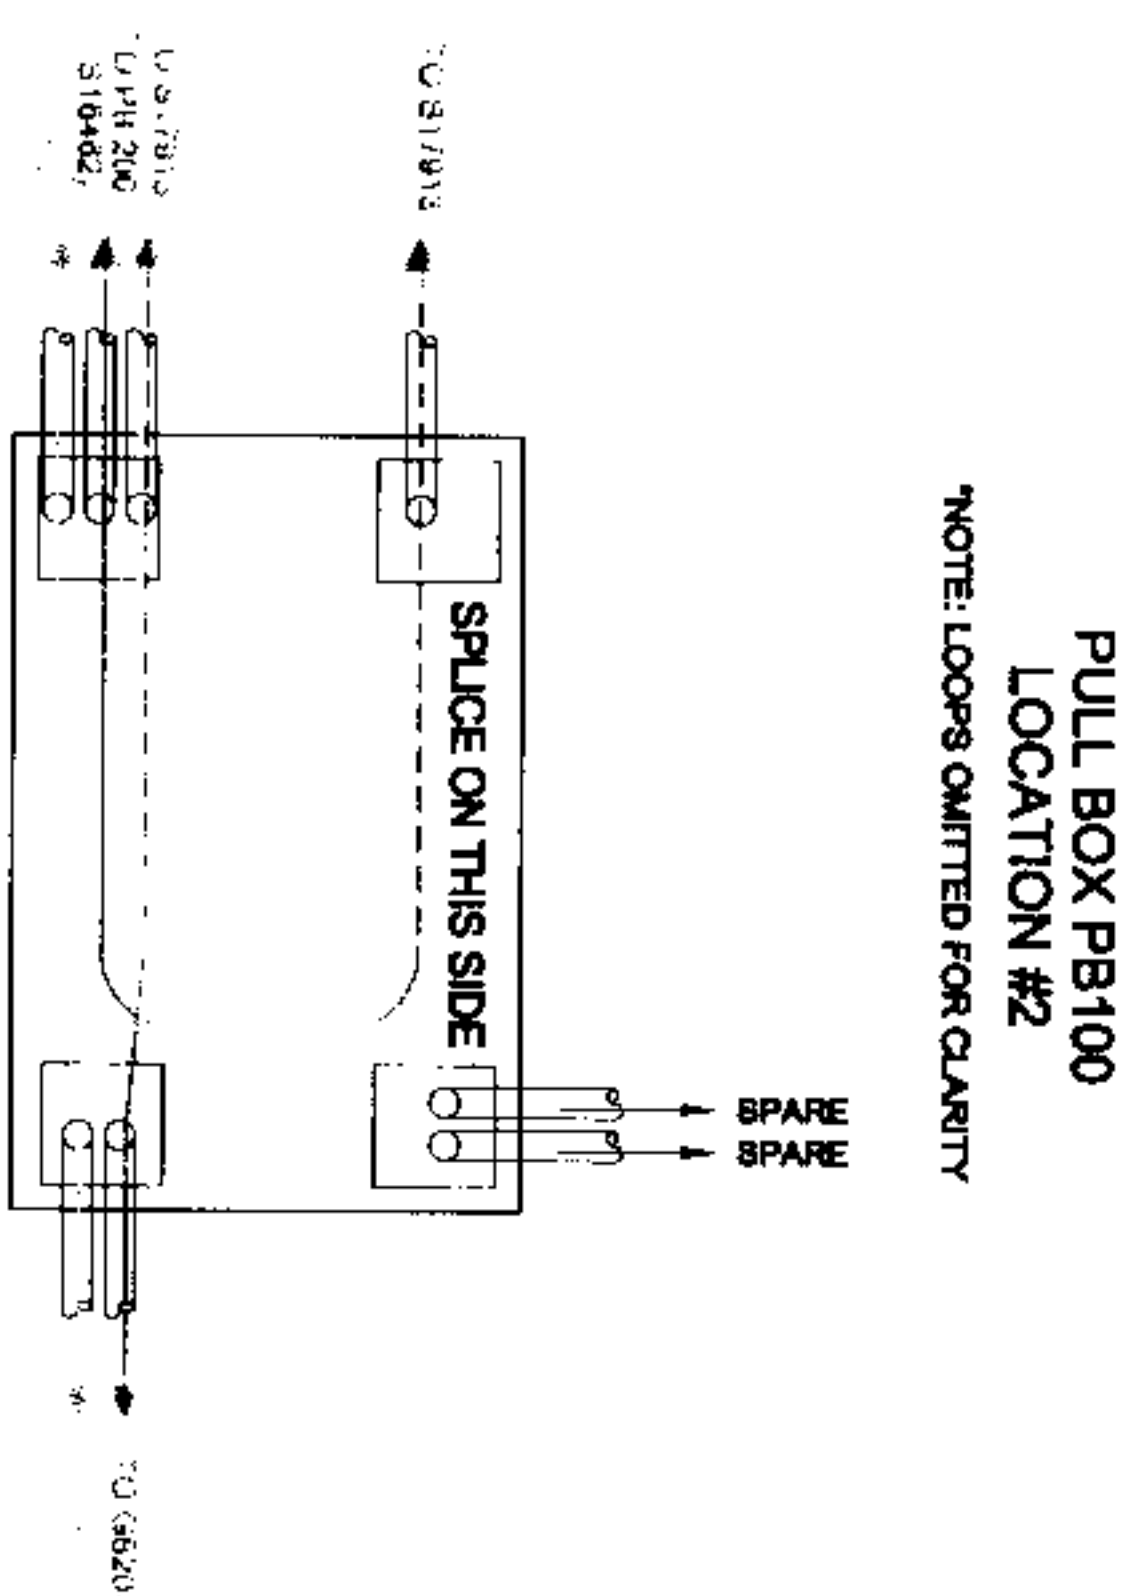

CONSTRUCTION COMPLETE

63

ANY CONSTRUCTION FIELD CHANGES ARE SHOWN IN RED ON THIS PRINT.

MAP REF:	SEC. 01, TPA. 185, R. 02
DRAWN	NNC
ENGR	B. HAMRICK
DATE	08/17/11
APPROVED	
DATE	

ALABAMA POWER COMPANY
AUTOMATED DRAWING - MAKE NO MANUAL REVISIONS
JOB BYAM SOUTHPLATTON CHAPEL
DETAIL PROVIDE SERVICE FOR BEAUMONT RETAIL
204 INVERNESS CENTER DR
SCALE 1" = 60' PLOTTED 08/15/11
SHEET 1 OF 1 SHEETS
UNPUBLISHED
D=6073-06-AH11