

4-6-89

LOT # 16 Block B

STATE OF ALABAMA  
SHELBY COUNTY

x                    x                    x  
x                    U93                    LEE & LILLIE MYREE  
    PO Box 756  
    COLUMBIANA, AL 35051

THIS INDEXTURE made and entered into on this the 6  
day of April, 1989, by and between CITY OF HELENA, ALABAMA  
Lillie Myree  
hereinafter called Grantors; and the Lillie Myree  
hereinafter called the Grantee;  
City of Helena

WITNESSETH:

WHEREAS, it has been found to provide the necessary utilities to  
certain areas lying within the CITY OF HELENA  
service area, SHELBY County, Alabama; that it has been found  
necessary to cross certain lands owned by the Grantors for the purpose of  
installing all necessary UTILITIES, and other such integral  
parts of the UTILITY;

WHEREAS, it has been found advantageous and to the best interest  
of Grantors and Grantee that an easement for such UTILITY be  
conveyed to the CITY OF HELENA

THEREFORE, in consideration of the sum of \$1.00  
and the mutual benefits accruing to the Grantors and to the CITY OF  
HELENA, SHELBY County, Alabama, the  
Grantors have this day bargained and conveyed and by these presents do hereby  
grant and convey unto the CITY OF HELENA, SHELBY  
County, Alabama, the following right, privilege and easement, in, to, along,  
over, through, under and across the hereinafter described lands:

The right and privilege to construct, erect, install,  
operate and maintain UTILITIES, on, upon, along,  
over, through, under and across the hereinafter described  
lands;

The right, privilege and easement to cut, trim and remove  
any brush, trees, or other obstructions upon the hereinafter  
described lands, together with the right of ingress and  
egress to and from, over and above the hereinafter described  
lands, for the purpose of the installation and upkeep of the  
UTILITIES.

BOOK  
321 PAGE 383

DESCRIPTION

A parcel of land being more particularly described as follows:

A 10'0 wide Storm and Sanitary Sewer easement running 100.0'  
parallel and along the South line of Lot 16,  
Block B in the Liberty Heights Subdivision Mapbook 3, Page 26  
as recorded in the Shelby County Probate office.

TO HAVE AND TO HOLD the above described right, privilege, and  
easements unto the City of Helena and to its assigns,  
together with the right of entry and reentry from time to time as occasion  
may require for the purpose of exercising its said rights, privileges and  
easements, hereinabove described.

IN WITNESS WHEREOF, we,

Lillie Myree

have hereunto set our hands and seals on this the day and year first above  
written.

4-6-89

Lraig Bonnell  
(Witness)

Majidah Sabree, for no myee (SEAL)

(SEAL)

(Witness)

(SEAL)

(Witness)

(SEAL)

(Witness)

(SEAL)

(Witness)

(SEAL)

(Witness)

(SEAL)

(Witness)

(SEAL)

321 PAGE 385  
BOOK

STATE OF ALABAMA

X

SHELBY COUNTY

X

X

I, the undersigned Notary Public, in and for said County in said State, hereby certify that Majidah Sabree for no myee

whose names are signed to the foregoing Easement and who are known to me, acknowledged before me on this day, that being informed of the contents of this Easement, she executed the same voluntarily on the day the same bears date.




GIVEN under my hand this the 6 day of April,  
19 89.

James Parish  
NOTARY PUBLIC

(SEAL)

No. Myee had just gotten out hospital & staying with Sabree family. Majidah is no myee daughter.

SEARCHED INDEXED SERIALIZED FILED  
3/21 PAGE 386

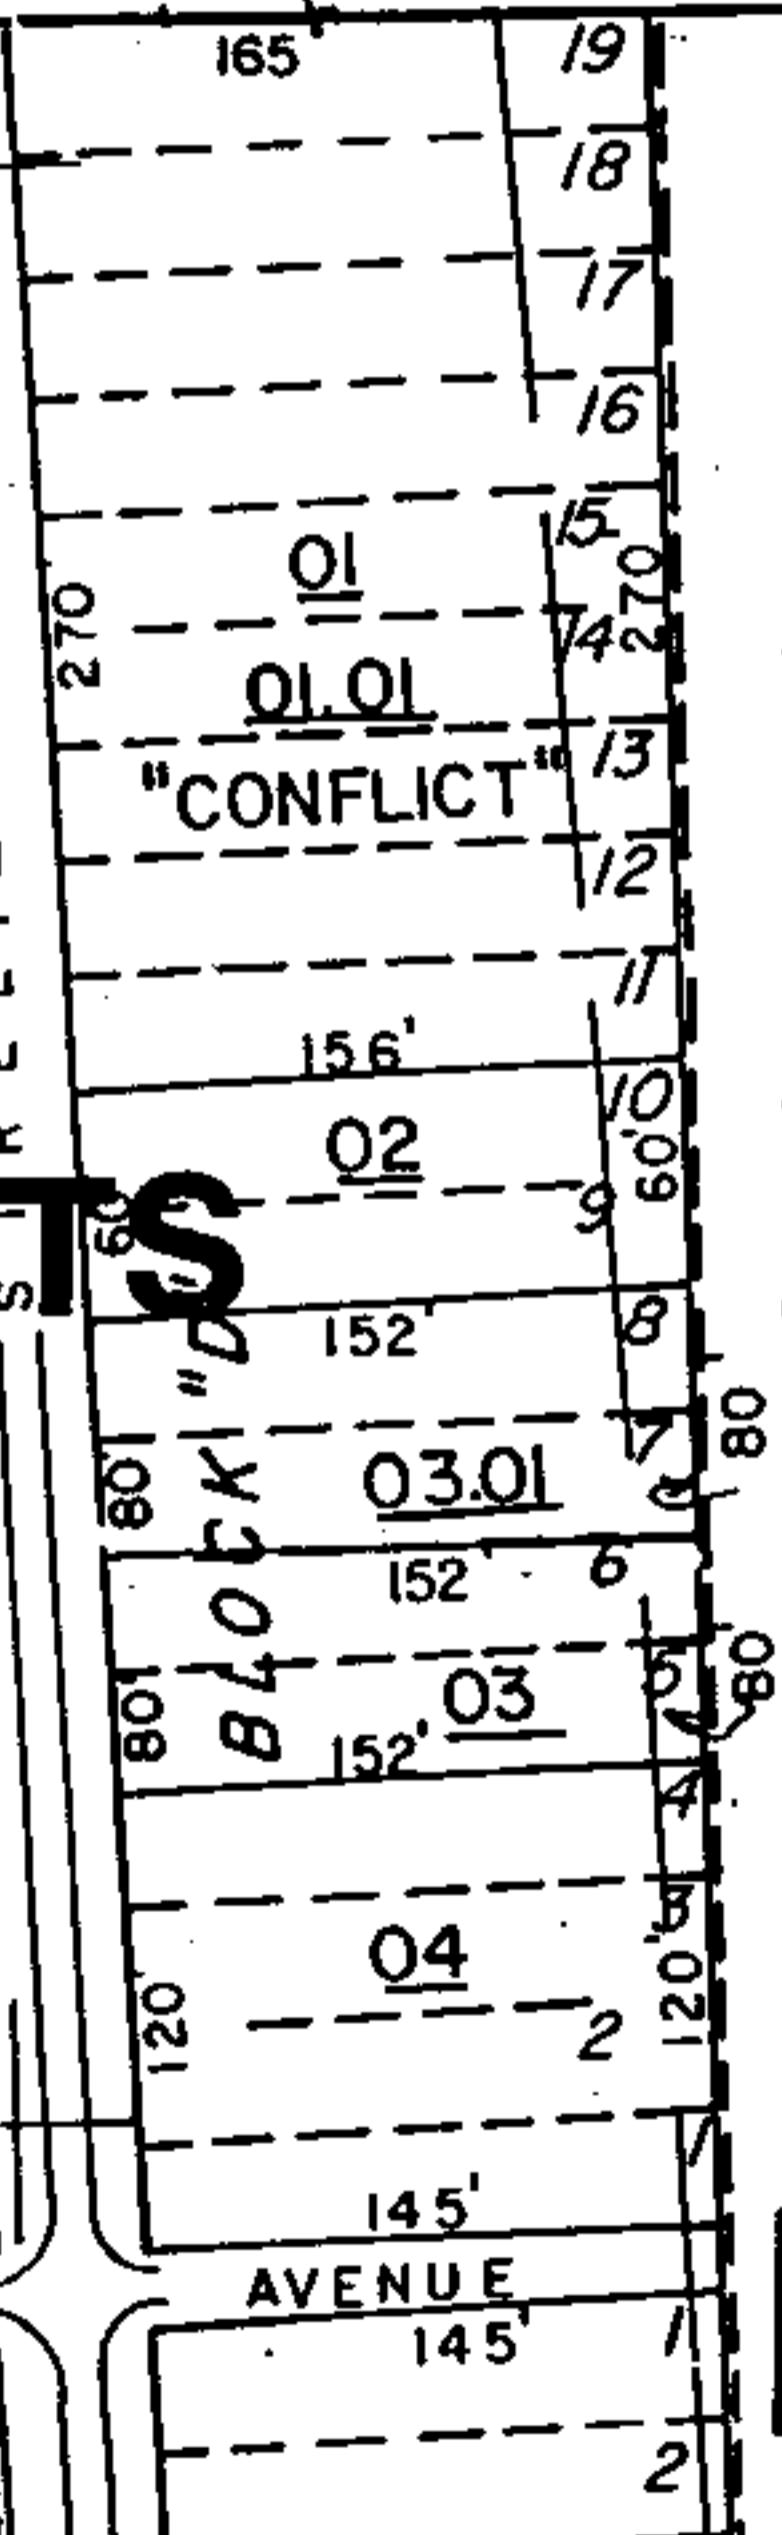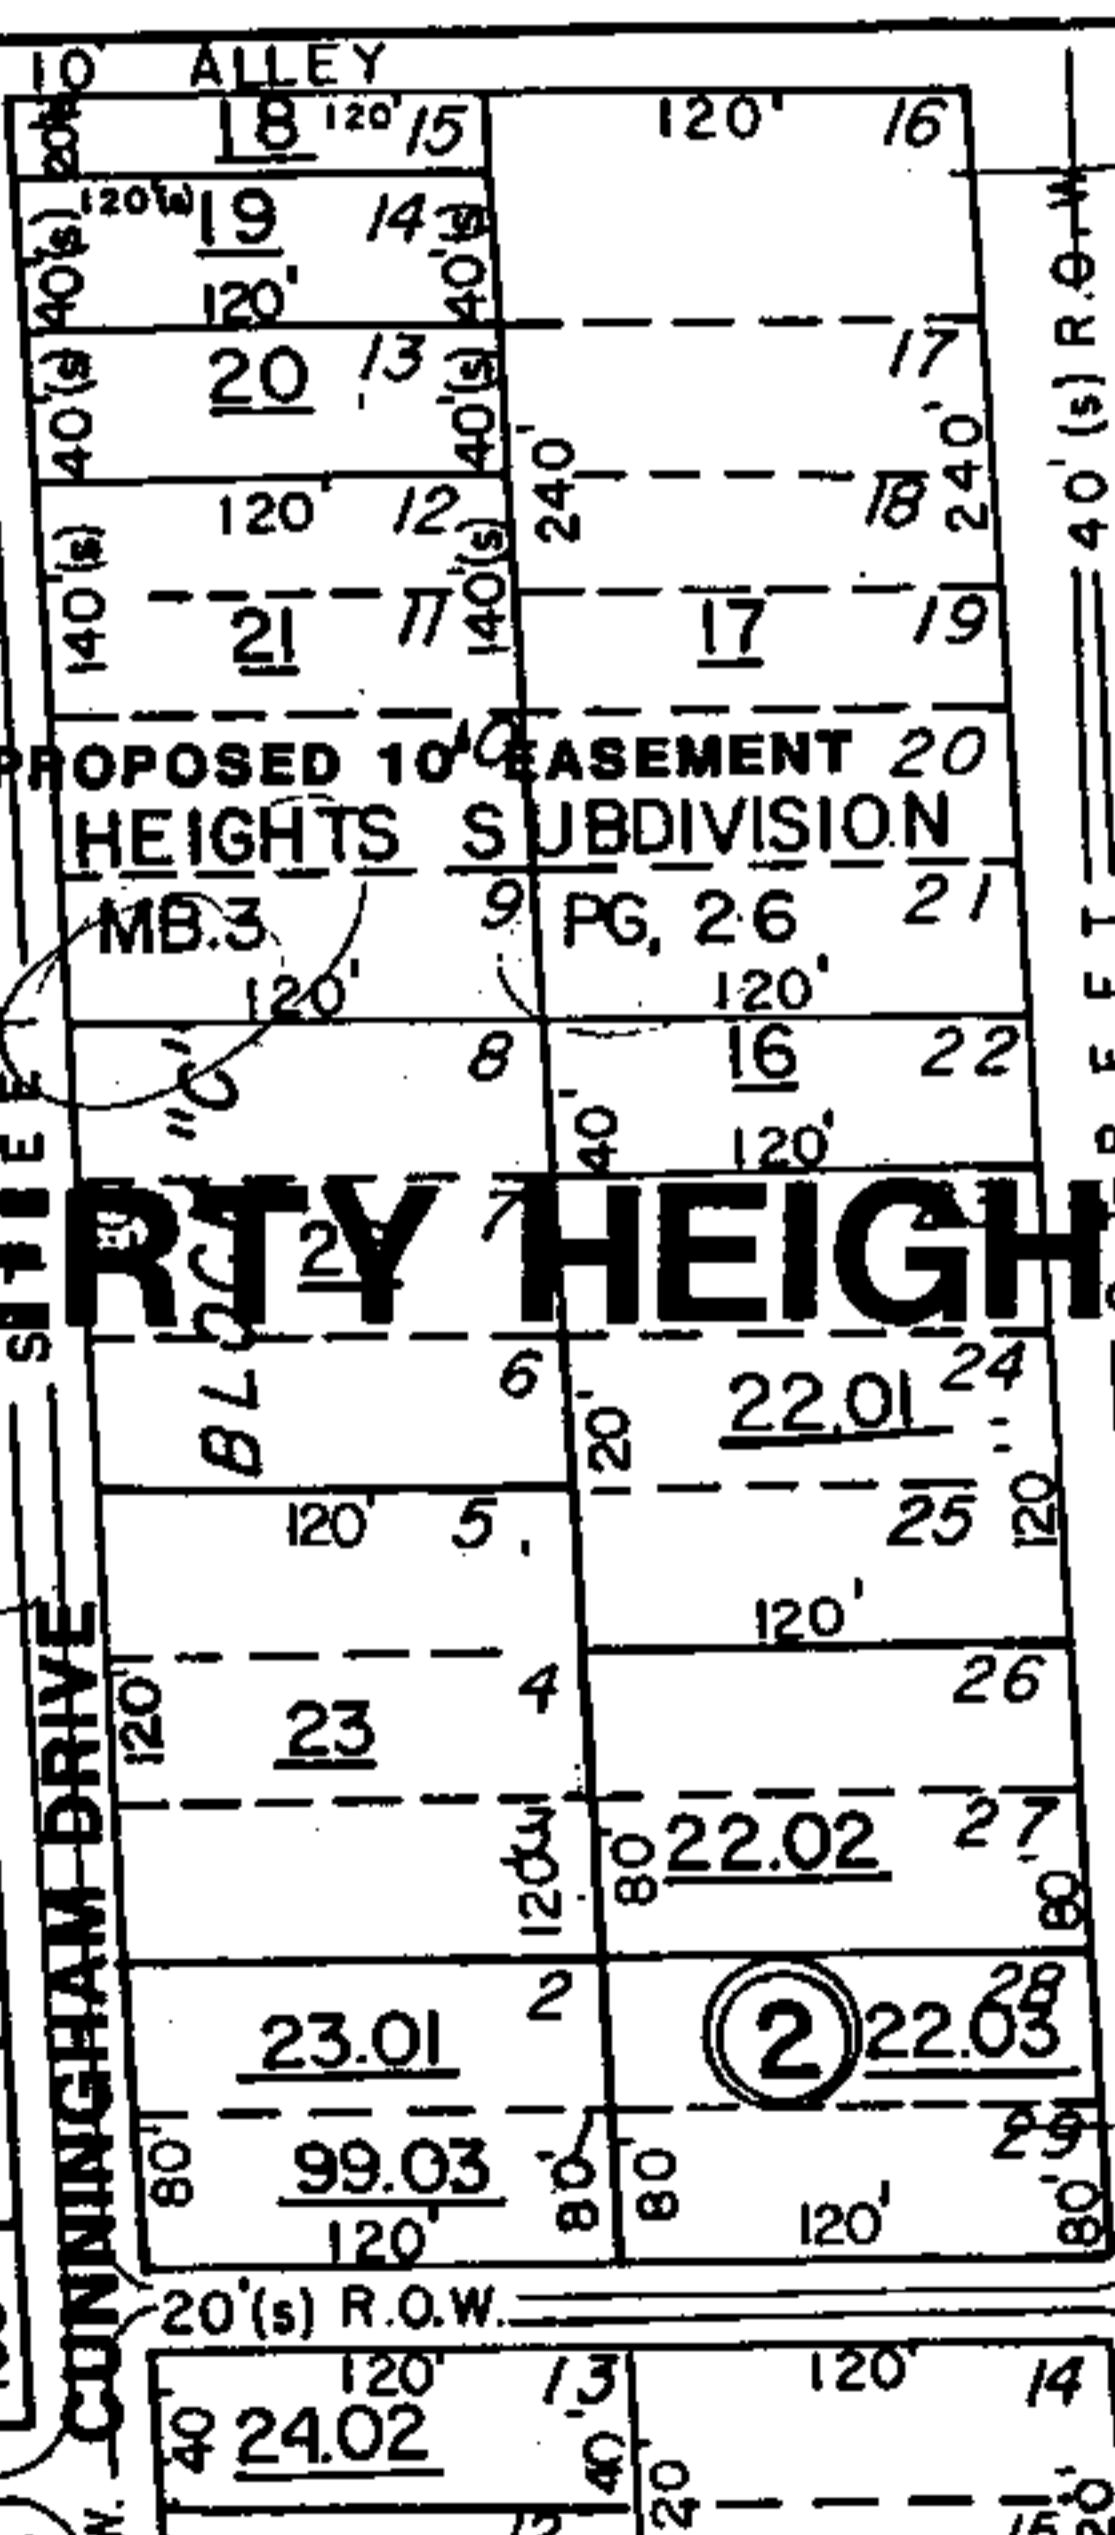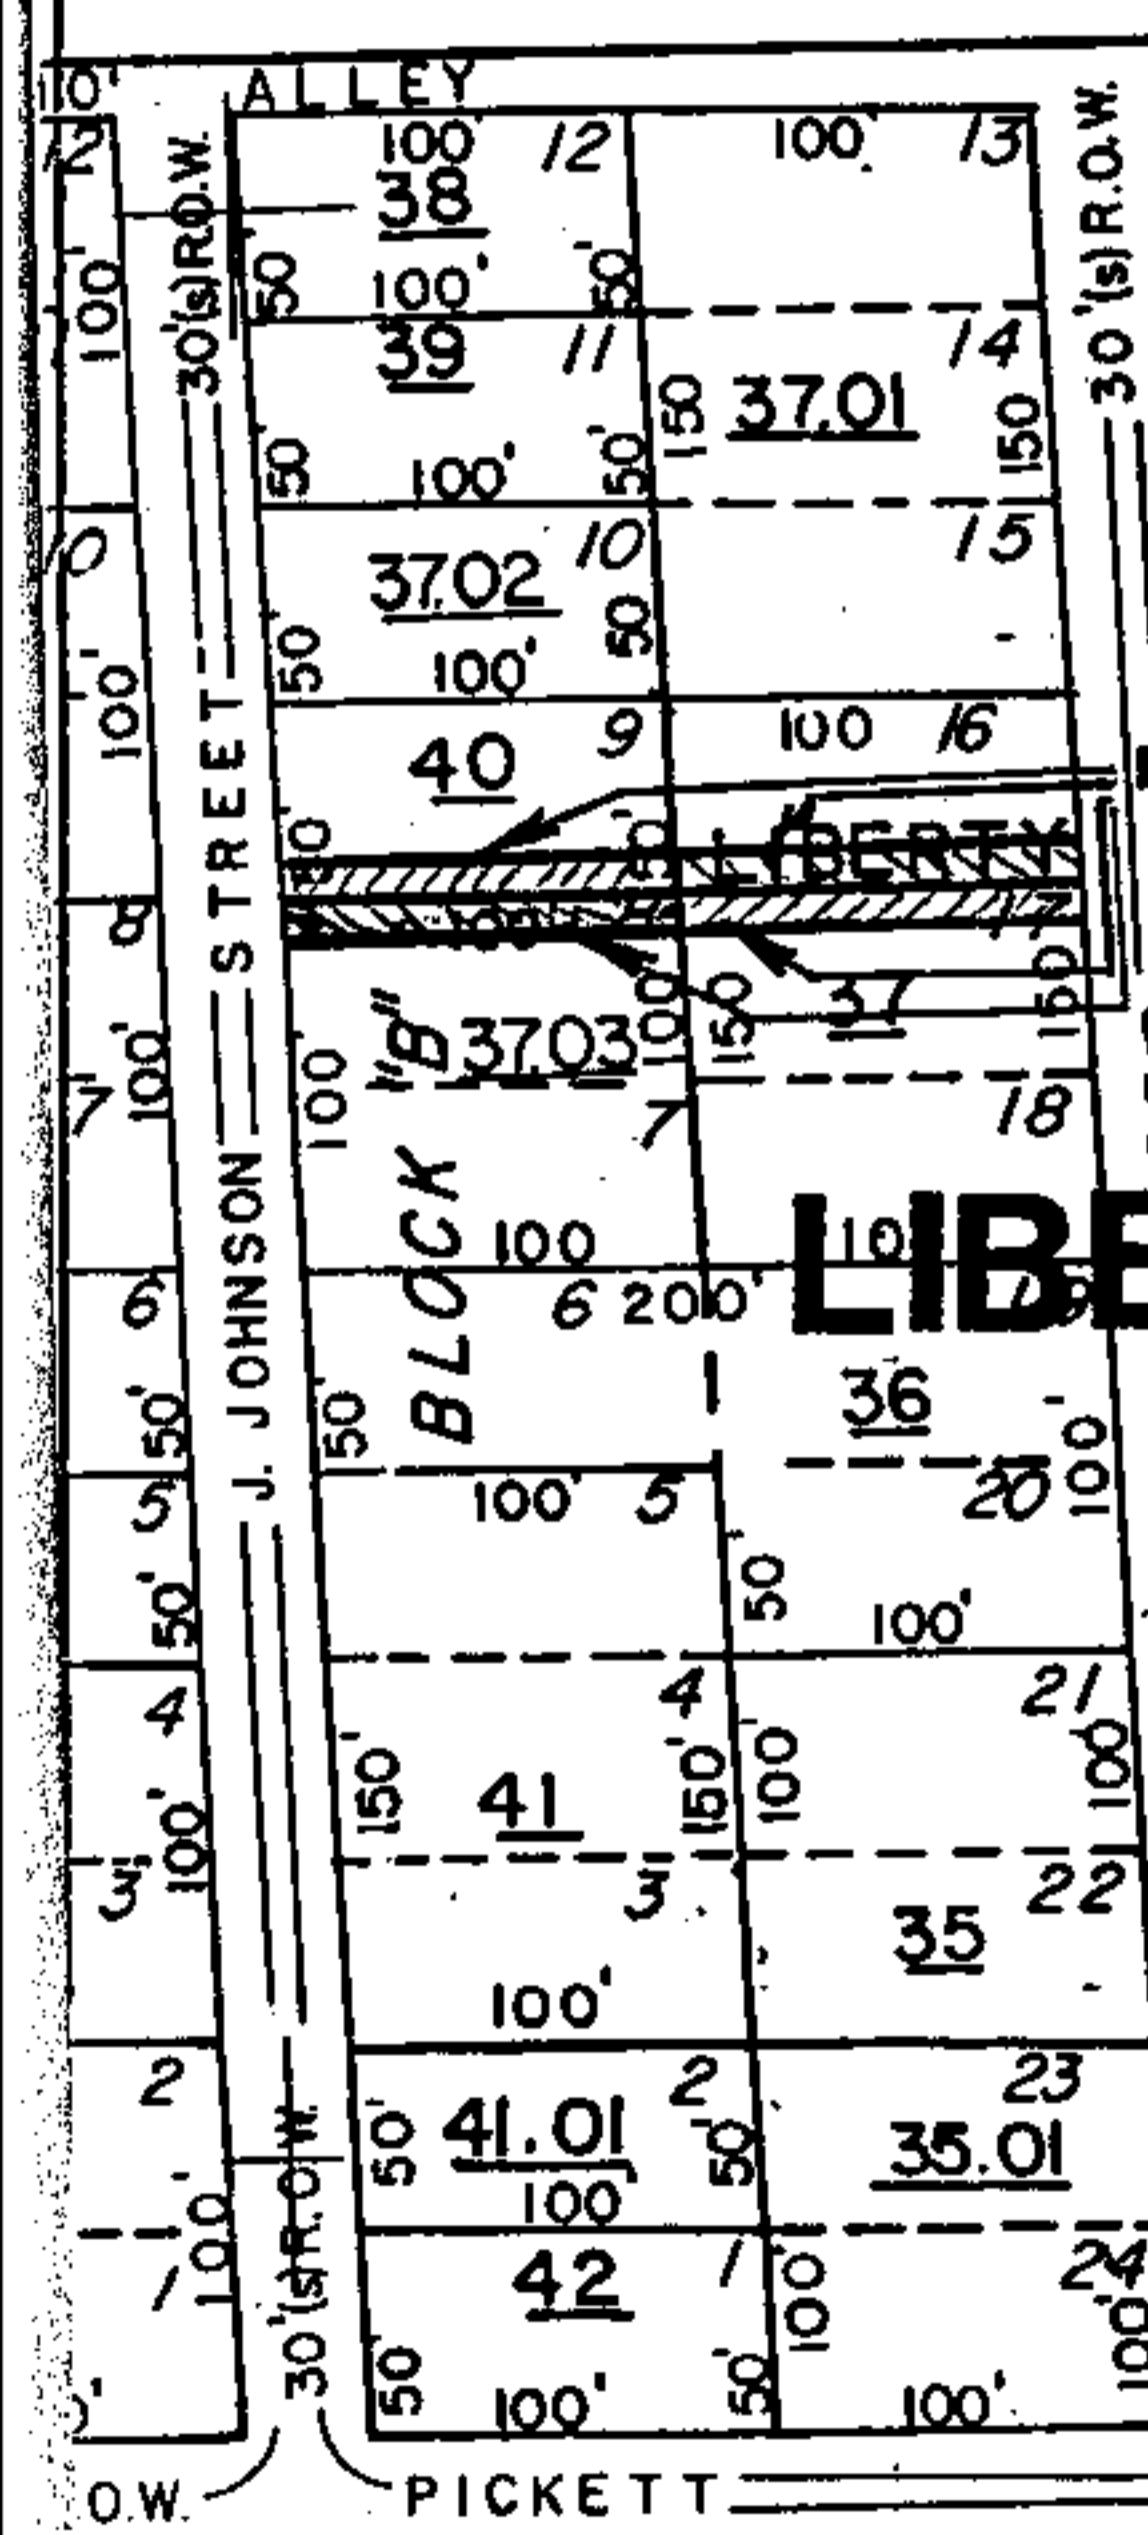

# LIBERTY HEIGHTS

SCALE: 1" = 100'

ORIGINAL

RECEIPT FOR YEAR: 1988

ACCOUNT NUMBER:  RECEIPT NUMBER:  

17360

**ANNETTE D. SKINNER, TAX COLLECTOR,  
SHELBY COUNTY, P.O. BOX 1298 COLUMBIANA, ALABAMA 35051**

ASSESSED VALUE	STATE TAX	COUNTY TAX	SCHOOL	SCHOOL DISTRICT	HOSPITAL	MUN. CODE	CITY	FOREST	FEE	TOTAL TAXES	
900	5.85	6.75	8.10	5.40	3.60	06	4.50	.00	.00	34.20	
								.00	.00	.00	
								.00	.00	.00	
								.00	.00	.00	
								.00	.00	.00	
AL. ONLY	.00	.00	.00	.00	.00					34.20	
NET TAXABLE VALUE	5.85	6.75	8.10	5.40	3.60						
PARCEL I.D.:	135151002037										34.20

NO PENALTY OR INTEREST WILL BE  
CHARGED IF PAID BEFORE DECEMBER 31.

OWNER NAME AND ADDRESS	INTEREST
MYREE LEE & LILLIE P O BOX 756 COLUMBIANA AL 35051	5.00
DEQ. FEE	1.71
CITATION	2.50
ADVERTISING	.00
PROBATE FEE	.00
POST MAIL	2.00
GRASS TAX	45.41

PAID BY SEE MYREE

*Calvin D. Skinner*

DATE PAID	11/10/88	CHECK <input type="checkbox"/>	CASH <input type="checkbox"/>	PAID BY
03/20/89	02			
MUNICIPAL CODES:				
02 - ALABASTER 03 - CALERA 04 - COLUMBIANA 05 - HARPERSVILLE				
06 - HELENA 07 - MONTEVALLO 08 - PELHAM 09 - VINCENT				
10 - WILSONVILLE 11 - WILTON 12 - LEEDS 13 - HOOVER				

MONEY ORDER	10 20 1989
<i>ANNETTE D. SKINNER</i>	

BOOK 321 PAGE 387

4-6-89

WAIVER OF RIGHTS AND BENEFITS OF THE UNIFORM  
RELOCATION ASSISTANCE AND REAL PROPERTY  
ACQUISITION POLICIES ACT OF 1970 (42 U.S.C. 4601)

WHEREAS, the City of Helena, Alabama, has received Community Development funds from the Alabama Department of Economic and Community Affairs, and;

WHEREAS, one of the conditions imposed upon the use of such funds is compliance with the requirements of the Uniform Relocation Assistance and Real Property Acquisition Policies Act of 1970 (42 U.S.C. 4601), hereafter referred to as the Uniform Act, and the regulations at 24 CFR Part 42 as revised February 27, 1986, and;

WHEREAS, the Uniform Act requires that real property shall be appraised before the initiation of negotiations, and;

WHEREAS, the Uniform Act requires that the City of Helena establish an amount it believes to be just compensation for the property to be acquired before the initiation of negotiations, and;

WHEREAS, as to the property specifically described as follows:

(Describe Property)

NOW, THEREFORE, let it be known that by signature hereon, I freely and without duress waive any and all rights and benefits accruing to me under the Uniform Act. Specifically, I have been advised by the City of Helena of my right to an appraisal and the payment of just compensation for the property to be acquired as described herein if I elect not to execute this waiver.

Majid Sabree for Mr. Myree  
Signature of Owner

Amy E. Carter  
Acquiring Official

BOOK  
321 PAGE  
388

321 PAGE 389  
BOOK

PRELIMINARY ACQUISITION NOTICE

Date 1-6-87

Name LEE & LILLIE MYREE  
Address Po Box 756  
Columbiana, AL 35051

Dear Sir:

The purpose of this letter is to formally notify you that the City of Helena is interested in acquiring a permanent easement and/or a temporary easement on a portion of your property described above. The City is interested in acquiring this easement so that a sanitary sewer system can be constructed to serve this neighborhood. A legal description of the easements to be acquired is attached.

Within a few days, Mr. Gary Carter or another representative of the City will be contacting you to advise you in more detail of the nature of the project. We have enclosed for your information a copy of the booklet "When a Public Agency Acquires Your Property" which helps explain the acquisition procedures.

Please note that this notice is PRELIMINARY IN NATURE AND IS NOT A NOTICE TO VACATE THE PROPERTY. It does not establish eligibility for relocation payments or other relocation assistance.

If you wish, you may donate the easement to the City. This will be discussed in more detail with you by a representative of the City. If you have any questions prior to being contacted again by the City, please call Mr. Gary Carter, at Helena City Hall. The phone number is (205) 663-2161.

STATE OF ALA. SHELBY CO.  
I CERTIFY THIS  
INSTRUMENT WAS FILED

90 DEC 10 PM 12:33

JUDGE OF PROBATE

Sincerely,  
CITY OF HELENA

  
Sonny Penhale  
Mayor

Enclosed: "When A Public Agency Acquires Your Property"

Received BY: Majid Sabur & Mrs. Myree

1. Deed Tax	\$	8
2. Mtg Tax	\$	8
3. Recording Fee	\$	11.50
4. Index	\$	5.00
5. Notary	\$	4
6. Certified Copy	\$	1.00

